

Walthall
 D 2019

MISSISSIPPI
 BOARD OF WATER COMMISSIONERS
 416 North State Street
 Jackson, Mississippi 39201

WATER WELL DRILLERS LOG

4-4 1982 Fitzgerald Well Serv Walthall
 date well completed firm name county well located

LANDOWNER:	description of formations encountered	from	to
Silbert Griffin RR. Tylutown (mailing address)			
WELL LOCATION:			
sec. 9 T 3 N R 11 E S W			
3 miles E of Salem (distance) (direction) (nearest town)			
WELL PURPOSE: Home (home, irrigation, municipal, industrial)			
WELL COMPLETION DATA:			
(1) diameter (inches) 4			
(2) total depth (feet) 130			
(3) static water level (feet) 75 below top of ground.			
(4) casing PVC, 122, (material) (depth) 4 if telescope see back. (size)			
(5) screen 8, 122 (length) (depth to top) 4, PVC (size) (material)			
(6) pump 1/2, 10 (HP) (yield gpm) elec (type power)			
(7) electric log no (yes or no) (organization running log)			
(8) how well bottom plugged S&S			
DRILLERS REMARKS:			


DEPT. OF NATURAL RESOURCES
 BUREAU OF LAND & WATER RESOURCES

MAY 25 1982

RECEIVED

If well telescopes please sketch and show depths.

GROUND LEVEL

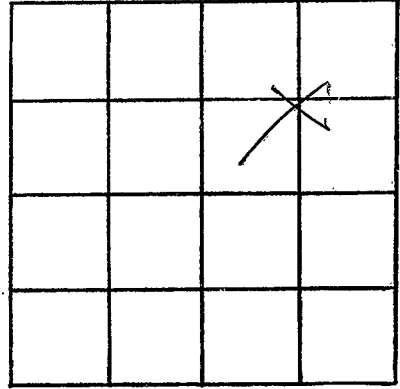

SECTION 9

Please indicate well location X.

ADDITIONAL INFORMATION

If more than one screen,
show locations of each on sketch.