

Walthell  
D 2553

MISSISSIPPI  
BOARD OF WATER COMMISSIONERS  
416 North State Street  
Jackson, Mississippi 39201

WATER WELL DRILLERS LOG

3-3 1982 Fitzgerald Wells Walthell  
date well completed firm name county well located

LANDOWNER:	description of formations encountered	from	to
Fay Steiner R.R. 14, Tatum, Miss. (mailing address)			

WELL LOCATION:  
sec. 15 T. 3 N R. 11 E  
S W  
3 miles E of Salem  
(distance) (direction) (nearest town)

WELL PURPOSE: Home  
(home, irrigation, municipal, industrial)

- WELL COMPLETION DATA:
- (1) diameter (inches) 4
  - (2) total depth (feet) 126
  - (3) static water level (feet) 90 below top of ground.
  - (4) casing PVC, 118, (material) (depth)  
4 (size) if telescope see back.
  - (5) screen 8, 118 (length) (depth to top)  
4 (size) PVC (material)
  - (6) pump 1/2 (HP) 10 (yield gpm)  
electric (type power)
  - (7) electric log no (yes or no)
  - (8) how well bottom plugged Seal hole

DRILLERS REMARKS:


DEPT. OF NATURAL RESOURCES  
BUREAU OF LAND & WATER RESOURCES

MAR 10 1982

RECEIVED

If well telescopes please sketch and show depths.

GROUND LEVEL

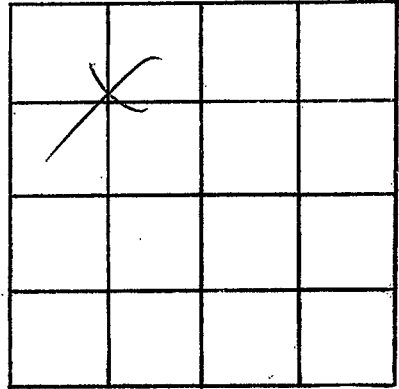

SECTION 15

Please indicate well location X.

ADDITIONAL INFORMATION

If more than one screen, show locations of each on sketch.