

MISSISSIPPI DEPARTMENT OF NATURAL RESOURCES

Bureau of Land and Water Resources

Southport Mall

P.O. Box 10631

Jackson, Mississippi 39209

WATER WELL DRILLERS LOG

Walthall
D2054

6-20 19 84
date well completed

Walthall
firm name

Walthall
county well located

LANDOWNER: Robert Short

description of formations encountered

from to

Clay	1	20
Sand & Gravel	20	80
Clay	80	115
Sand	115	151

(mailing address)

WELL LOCATION:

sec. 17 T. 3 N. R. 11 E
S W
2 miles NE of Tylertown
(distance) (direction) (nearest town)

WELL PURPOSE: home
(home, irrigation, municipal, industrial)

WELL COMPLETION DATA:

- (1) diameter (inches) 4
(2) total depth (feet) 151
(3) static water level (feet) 82 below top of ground.

(4) casing PVC, 141
(material) (depth)
4"
(size) If telescope see back.

(5) screen 10', 141'
(length) (depth to top)
.010 PVC
(size) (material)


(6) pump _____ (HP) _____ (yield gpm)
(type power)

(7) electric log NO
(yes or no)

(organization running log)


(8) how well bottom plugged back wash valve

DRILLERS REMARKS:

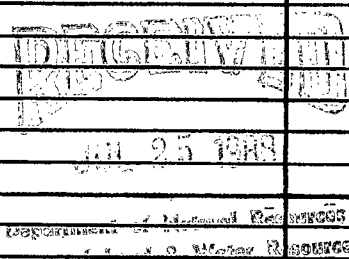

If well telescopes please sketch and show depths.

GROUND LEVEL

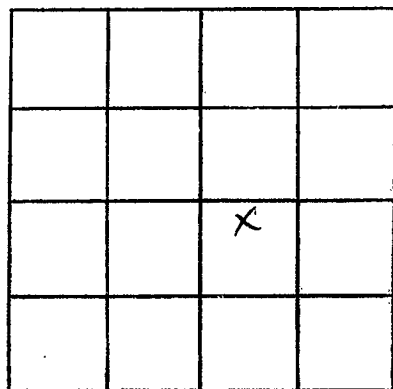

SECTION 17

Please indicate well location X.

ADDITIONAL INFORMATION

If more than one screen,
show locations of each on sketch.