

WALTHALL
D JOSS

MISSISSIPPI DEPARTMENT OF NATURAL RESOURCES
Bureau of Land and Water Resources
Southport Mall
P.O. Box 10631
Jackson, Mississippi 39209
WATER WELL DRILLERS LOG

8-26 1986 *F. J. ...* *Walthall*
date well completed firm name county well located

LANDOWNER:
Ken Walp
R.B. Jeyson, m.
(mailing address)

description of formations encountered	from	to
<i>Red clay</i>	<i>6</i>	<i>20</i>
<i>Red sand</i>	<i>20</i>	<i>114</i>
<i>Coarse sand & gravel</i>	<i>114</i>	<i>126</i>

WELL LOCATION:
sec. 10 T. 3 N. R. 11 E
S W
3 miles E of SALEM
(distance) (direction) (nearest town)

WELL PURPOSE: Home
(home, irrigation, municipal, industrial)

- WELL COMPLETION DATA:
- (1) diameter (inches) 4
 - (2) total depth (feet) 126
 - (3) static water level (feet) 62 below above top of ground.
 - (4) casing 4" PVC 116'
(material) (depth)
4 if telescope see back.
(size)
 - (5) screen 10' 116'
(length) (depth to top)
4" PVC
(size) (material)
 - (6) pump 1/2 HP 10 gpm
(HP) (yield gpm)
elec
(type power)
 - (7) electric log no
(yes or no)
(organization running log)
 - (8) how well bottom plugged Sealed


DRILLERS REMARKS:

RECEIVED
SEP 9 0 1986

Department of Natural Resources
Bureau of Land & Water Resources

If well telescopes please sketch and show depths.

GROUND LEVEL

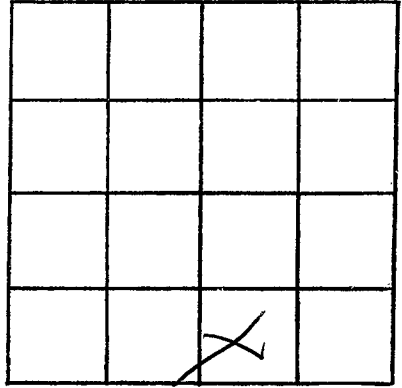

SECTION 10

Please indicate well location X.

ADDITIONAL INFORMATION

If more than one screen,
show locations of each on sketch.