

MISSISSIPPI DEPARTMENT OF NATURAL RESOURCES

Bureau of Land and Water Resources

Southport Mall

P.O. Box 10631

Jackson, Mississippi 39209

WATER WELL DRILLERS LOG

WALTHAM
D JOSE

Griner Drilling Service, Inc. Waltham

4-14-88 date well completed

Griner Drilling Service, Inc. firm name

county well located

LANDOWNER:
Chesley Pruet Drilling
P.O. Box 324
Laurel, Ms. 39440
(mailing address)

description of formations encountered	from	to
clay, sand	0	21
clay, sand, pea gravel, mostly	21	200
pea gravel & clay		
sand, pea gravel	200	260
sand, clay	260	394

WELL LOCATION: 1014' W & 330' W
of N. Darbin Field
1/4 sec 4 T 3 N R 11 E of W SE/4 or
(distance) (direction) (nearest town)

WELL PURPOSE: oilfield, rig supply
(home, irrigation, municipal, industrial)

WELL COMPLETION DATA:

- (1) diameter (inches) 3"
- (2) total depth (feet) 294'
- (3) static water level (feet) 60' below top of ground.
- (4) casing steel, 2 1/2" (material) (depth)
3" (size) if telescope see back.
- (5) screen 42' (length) 210' (depth to top)
3" (size) perforated (material)
- (6) pump AC (type power) 75-80 (yield gpm)
- (7) electric log (yes or no)
- (8) how well bottom plugged orange

RECEIVED


MAY 20 1988

Department of Natural Resources
Bureau of Land & Water Resources

DRILLERS REMARKS:

If well telescopes please sketch and show depths.

GROUND LEVEL

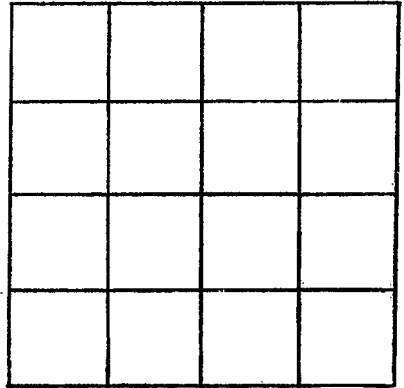

SECTION _____

Please indicate well location X.

ADDITIONAL INFORMATION

If more than one screen, show locations of each on sketch.