

MISSISSIPPI DEPARTMENT OF NATURAL RESOURCES

Bureau of Land and Water Resources

P.O. Box 10631

Jackson, Mississippi 39209

WATER WELL DRILLERS LOG

COUNTY WELL LOCATED
Walthall

WELL NUMBER **D** CODED

2058

DATE WELL COMPLETED
May 11-90

PERMIT NUMBER

NAME OF DRILLING FIRM
FITZGERALD Well Serv

NAME & MAILING ADDRESS OF LANDOWNER
Louise Strait
P.O. Giletown Ms.

PUMP DATA

PUMP TYPE (Circle One):
 Submersible, Turbine, Jet, Flowing Well,
Other (Describe) _____

POWER TYPE (Circle One):
 Electric, Tractor, Diesel, Gasoline, Butane,
Other (Describe) _____ H/P _____

Pump Capacity (GPM) **25** No. of Stages **7** Setting Depth **80** FT.

WELL LOCATION: SEC 3 TOWNSHIP 3 RANGE N 11 E

DISTANCE 3 Miles E N E of SALEM

OTHER LANDMARK

PUMP TEST

Well yielded 25 GPM with
a drawdown of 4 ft.
after 2 hours of pumping

WELL PURPOSE: Home, Irrigation, Municipal, Industrial, Fish Pond, etc.
Home

WELL DATA

Well Depth 135 Casing Diameter (In.) 4 Casing Length (Ft.) 125

Type of Casing PSC Hole Depth 135 Depth to Static Water Level 30

LOG DATA

TYPE OF LOG RUN (Circle One): No Log Run,
Electric, Gamma Ray, Density, Sonic, Neutron,
Other (Describe) _____

Name of Organization Running Log

TYPE OF COMPLETION: (Circle One or More):
 Gravel Packed, Underreamed, Telescoped,
 Natural Development, Open Hole, Other

Top of Lap Pipe or Reduction in Casing

FEET IF TELESCOPED OR MORE THAN ONE SCREEN: USE BACK PAGE

GEOLOGIC DATA (Office Use Only)

Surface Elev.	Geologic Unit	Unit Thickness	Depth to Top
Subs. SWL	Date	Analysis	Aquifer Test

SCREEN DATA

Diameter - Inches <u>4</u>	Length - Feet <u>10</u>	Slot Size - Inches <u>1014</u>
Screen Type <u>PSC</u>	Depth to Bottom - Feet <u>135</u>	

Driller's Remarks

DESCRIPTION OF FORMATIONS ENCOUNTERED	FROM	TO
<i>Red Clay</i>	<i>0</i>	<i>10</i>
<i>Red Sand</i>	<i>10</i>	<i>122</i>
<i>Coarse Sand & gravel</i>	<i>122</i>	<i>135</i>

FORMATIONS (Continued)

RECEIVED


JUN 14 1990

Department of Natural Resources
Bureau of Land & Water Resources

IF MORE SPACE IS NEEDED, USE BACK

If well telescopes please
sketch and show depths.

GROUND LEVEL

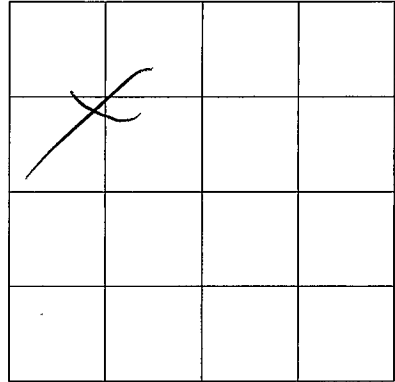

SECTION 3

Please indicate well location X.

ADDITIONAL INFORMATION

If more than one screen,
show location of each on sketch.