

WALHAAC
Daosa

MISSISSIPPI DEPARTMENT OF NATURAL RESOURCES
Bureau of Land and Water Resources
Southport Mall
P.O. Box 10631
Jackson, Mississippi 39209
WATER WELL DRILLERS LOG

9-26-90
date well completed

90 Fitzgerald well Serv
firm name

wellhead
county well located

LANDOWNER:
Lane Chance
R.R. Lytle town ms.
(mailing address)

description of formations encountered	from	to
<u>Red clay</u>	<u>0</u>	<u>20</u>
<u>Red sand</u>	<u>20</u>	<u>25</u>
<u>Coarse sandstone</u>	<u>25</u>	<u>115</u>

WELL LOCATION:
sec. 1 T 3 N R 11 E
S W
1 1/2 miles S of DARRUN
(distance) (direction) (nearest town)

WELL PURPOSE: Home
(home, irrigation, municipal, industrial)


- WELL COMPLETION DATA:
- (1) diameter (inches) 4
 - (2) total depth (feet) 115
 - (3) static water level (feet) 49 below above top of ground.
 - (4) casing PVC, 105,
(material) (depth)
4
(size) if telescope see back.
 - (5) screen 10, 105
(length) (depth to top)
4, PVC
(size) (material)
 - (6) pump 1/2, 10
(HP) (yield gpm)
elec
(type power)
 - (7) electric log No
(yes or no)
(organization running log)
 - (8) how well bottom plugged Loose Shale

DRILLERS REMARKS:

RECEIVED
NOV 27 1990
Department of Natural Resources
Bureau of Land & Water Resources

If well telescopes please sketch and show depths.

GROUND LEVEL

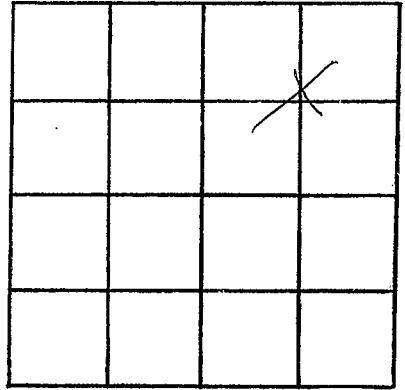

SECTION /

Please indicate well location X.

ADDITIONAL INFORMATION

If more than one screen,
show locations of each on sketch.