

## Office of Land and Water Resources

COUNTY WELL LOCATED	
WATTHP	
WELL NUMBER	CODED
D	
2064	
DATE WELL COMPLETED	
APR 20-93	

PERMIT NUMBER

NAME OF DRILLING FIRM

F. T. GERALD Welsh

NAME &amp; MAILING ADDRESS OF LANDOWNER

MILTON JACKSON  
R.R. Lytle town ms.

WELL LOCATION: SEC TOWNSHIP RANGE  
16 3 N 11 E

DISTANCE		DIRECTION		NEAREST TOWN
<u>3</u>	Miles	<u>E</u>	of	<u>SALem</u>

OTHER LANDMARK \_\_\_\_\_

**WELL PURPOSE:** Home, Irrigation, Municipal, Industrial, Fish Pond, etc.

## WELL DATA

Well Depth 114	Casing Diameter (In.) 4	Casing Length (Ft.) 104
Type of Casing PVC	Hole Depth 114	Depth to Static Water Level 74

TYPE OF COMPLETION: (Circle One or More):

Gravel Packed,	Underreamed,	Telescoped,
Natural Development,	Open Hole,	Other
(Describe)		

WELL GROUTED TO A DEPTH OF 10 FEET  
Type Grout (circle one): Cement, Bentonite, or Mix

## SCREEN DATA

Diameter - Inches 4	Length - Feet 10	Slot Size - Inches 1014
Screen Type ASC		Depth to Bottom - Feet 114

## PUMP DATA

~~PUMP~~ TYPE (Circle One):

Submersible, Turbine, Jet Flowing Well,  
Other (Describe)

POWER TYPE (Circle One):

Electric, Tractor, Diesel, Gasoline, Butane,  
Other (Describe) H/P 1/2

Pump Capacity (GPM)	No. of Stages	Setting Depth
10	8	104 FT.

## PUMP TEST

Well yielded 15 GPM with  
a drawdown of 3 ft.  
after 2 hours of pumping

## LOG DATA

TYPE OF LOG RUN (Circle One):

No Log Run.


Electric, Gamma Ray, Density, Sonic, Neutron,  
Other (Describe)

Name of Organization Running Log

## GEOLOGIC DATA (Office Use Only)


Surface Elev.	Geologic Unit	Unit Thickness	Depth to Top
Subs. SWL	Date	Analysis	Aquifer Test

Driller's Remarks

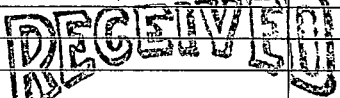DESCRIPTION OF FORMATIONS ENCOUNTERED	FROM	TO	FORMATIONS (Continued)	FROM	TO
Red Clay Red Sand Course Sand	0 20 90	20 90 114	 JUN 25 1993 Dept. of Environmental Quality Office of Land & Water Resources		
			IF MORE SPACE IS NEEDED, USE BACK		

If well telescopes please  
sketch and show depths.

GROUND LEVEL

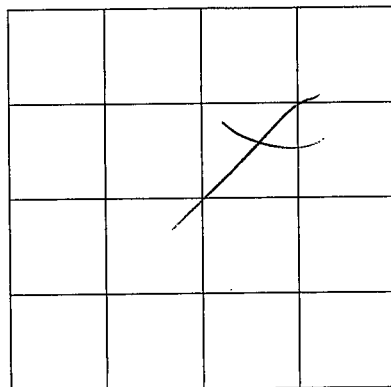

SECTION

16

Please indicate well location X.

ADDITIONAL INFORMATION

If more than one screen,  
show location of each on sketch.