

MISSISSIPPI DEPARTMENT OF ENVIRONMENTAL QUALITY

Office of Land and Water Resources

P. O. Box 10631
Jackson, MS 39289-0631
WATER WELL DRILLERS LOG

COUNTY WELL LOCATED <u>WORTHALL</u>	
WELL NUMBER <u>D</u>	CODED
DATE WELL COMPLETED <u>NOV 12 - 93</u>	

PERMIT NUMBER
NAME OF DRILLING FIRM <u>F. TIGERMAN Well Serv</u>

NAME & MAILING ADDRESS OF LANDOWNER <u>LARRY WILL G:HN</u> <u>RR. Glaston ms.</u>		
WELL LOCATION: SEC <u>7</u> TOWNSHIP <u>3</u> RANGE <u>11</u>	N S E W	
DISTANCE <u>1</u> Miles	DIRECTION <u>W</u>	NEAREST TOWN <u>Salem</u>
OTHER LANDMARK		
WELL PURPOSE: Home, Irrigation, Municipal, Industrial, Fish Pond, etc. <u>Home</u>		

PUMP DATA		
PUMP TYPE (Circle One): <input checked="" type="checkbox"/> Submersible, <input type="checkbox"/> Turbine, <input type="checkbox"/> Jet, <input type="checkbox"/> Flowing Well, Other (Describe) _____		
POWER TYPE (Circle One): <input checked="" type="checkbox"/> Electric, <input type="checkbox"/> Tractor, <input type="checkbox"/> Diesel, <input type="checkbox"/> Gasoline, <input checked="" type="checkbox"/> Butane, Other (Describe) _____ H/P <u>1/2</u>		
Pump Capacity (GPM) <u>10</u>	No. of Stages <u>8</u>	Setting Depth <u>100</u> FT.
PUMP TEST		
Well yielded <u>25</u> GPM with a drawdown of <u>2</u> ft. after <u>2</u> hours of pumping		

WELL DATA		
Well Depth <u>117</u>	Casing Diameter (In.) <u>4</u>	Casing Length (Ft.) <u>107</u>
Type of Casing <u>PUC</u>	Hole Depth <u>117</u>	Depth to Static Water Level <u>76</u>
TYPE OF COMPLETION: (Circle One or More): <input checked="" type="checkbox"/> Gravel Packed, <input type="checkbox"/> Underreamed, <input type="checkbox"/> Telescoped, <input type="checkbox"/> Natural Development, <input type="checkbox"/> Open Hole, <input type="checkbox"/> Other (Describe) _____		

LOG DATA	
TYPE OF LOG RUN (Circle One): <input checked="" type="checkbox"/> No Log Run, <input type="checkbox"/> Electric, <input type="checkbox"/> Gamma Ray, <input type="checkbox"/> Density, <input type="checkbox"/> Sonic, <input type="checkbox"/> Neutron, Other (Describe) _____	
Name of Organization Running Log	

WELL GROUTED TO A DEPTH OF <u>10</u> FEET
Type Grout (circle one): Cement, Bentonite, <input checked="" type="checkbox"/> or Mix

GEOLOGIC DATA (Office Use Only)			
Surface Elev.	Geologic Unit	Unit Thickness	Depth to Top
Subs. SWL	Date	Analysis	Aquifer Test

SCREEN DATA		
Diameter - Inches <u>4</u>	Length - Feet <u>10</u>	Slot Size - Inches <u>1014</u>
Screen Type <u>PUC</u>	Depth to Bottom - Feet <u>117</u>	


Driller's Remarks

DESCRIPTION OF FORMATIONS ENCOUNTERED	FROM	TO	FORMATIONS (Continued)	FROM	TO
<u>Red clay</u>	<u>0</u>	<u>20</u>	REGISTERED JAN 05 1994 Dept. of Environmental Quality Office of Land & Water Resources		
<u>Red sand</u>	<u>20</u>	<u>104</u>			
<u>Coarse sand & gravel</u>	<u>104</u>	<u>117</u>			

IF MORE SPACE IS NEEDED, USE BACK

If well telescopes please sketch and show depths.

GROUND LEVEL

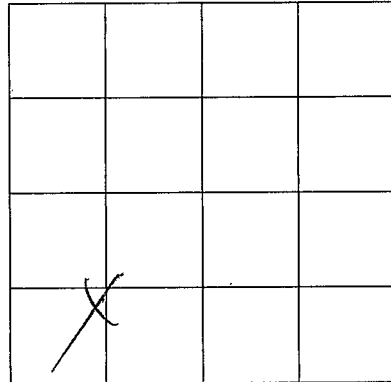

SECTION 7

Please indicate well location X.

ADDITIONAL INFORMATION

If more than one screen,
show location of each on sketch.