

Walthall
D 2009

MISSISSIPPI
BOARD OF WATER COMMISSIONERS
416 North State Street
Jackson, Mississippi 39201

WATER WELL DRILLERS LOG

MMR 15 1994 E. FERGUSON Well Service Walthall
date well completed firm name county well located

LANDOWNER:	description of formations encountered	from	to
<u>Ernest Pittman</u>			
<u>Ab. G. Johnson, Inc.</u> (mailing address)	<u>Red clay</u> <u>Red sand</u> <u>Coarse sand/gravel</u>	<u>6</u> <u>15</u> <u>96</u>	<u>10</u> <u>96</u> <u>120</u>
WELL LOCATION: sec. <u>15</u> T <u>3</u> N R <u>11</u> E S W <u>3</u> miles <u>E</u> of <u>Salem</u> (distance) (direction) (nearest town)			
WELL PURPOSE: <u>Drinking Water</u> (home, irrigation, municipal, industrial)			
WELL COMPLETION DATA: (1) diameter (inches) <u>4</u> (2) total depth (feet) <u>120</u> (3) static water level (feet) <u>63</u> below top of ground. above (4) casing <u>PVC</u> , <u>100</u> (material) (depth) <u>4</u> If telescope see back. (size) (5) screen <u>20</u> , <u>100</u> (length) (depth to top) <u>4</u> , <u>PVC</u> (size) (material) (6) pump <u>2</u> , <u>35</u> (HP) (yield gpm) <u>Electric</u> (type power) (7) electric log <u>Yes</u> (yes or no) <u>Elmer</u> (organization running log) (8) how well bottom plugged <u>Small</u>			
DRILLERS REMARKS:			


RECEIVED

JUN 17 1994

Dept. of Environmental Quality
Office of Land & Water Resources

If well telescopes please sketch and show depths.

GROUND LEVEL

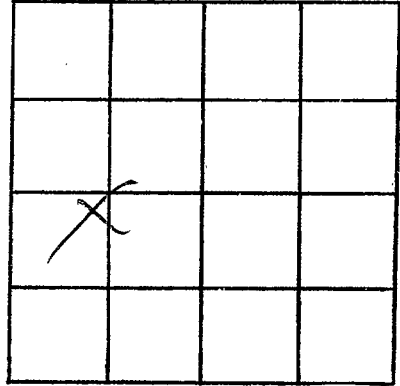

SECTION 15

Please indicate well location X.

ADDITIONAL INFORMATION

A series of horizontal lines for recording additional information.

If more than one screen, show locations of each on sketch.