

MISSISSIPPI DEPARTMENT OF ENVIRONMENTAL QUALITY

Office of Land and Water Resources

P. O. Box 10631  
Jackson, MS 39289-0631

WATER WELL DRILLERS LOG

COUNTY WELL LOCATED  
**WALTHALL**

WELL NUMBER CODED  
**D 2079**

DATE WELL COMPLETED  
**8-28-97**

PERMIT NUMBER  
**0-287**

NAME OF DRILLING FIRM  
**REEVES WELL SER**

NAME & MAILING ADDRESS OF LANDOWNER  
**L.C. Smith**

WELL LOCATION: SEC **28** TOWNSHIP **3** RANGE **11**

DISTANCE **8** Miles DIRECTION **N** NEAREST TOWN **TYLER TOWN**

OTHER LANDMARK

WELL PURPOSE: Home, Irrigation, Municipal, Industrial, Fish Pond, etc.  
**HOME**

PUMP DATA

PUMP TYPE (Circle One):  
Submersible, Turbine, Jet, Flowing Well, Other (Describe)

POWER TYPE (Circle One):  
Electric, Tractor, Diesel, Gasoline, Butane, Other (Describe) H/P

Pump Capacity (GPM) No. of Stages Setting Depth

PUMP TEST  
Well yielded **80** GPM with a drawdown of **0** ft. after **1** hours of pumping

WELL DATA

Well Depth <b>120</b>	Casing Diameter (In.) <b>4"</b>	Casing Length (Ft.) <b>20'</b>
Type of Casing <b>PVC</b>	Hole Depth <b>120</b>	Depth to Static Water Level <b>50'</b>

TYPE OF COMPLETION: (Circle One or More):  
Gravel Packed, Underreamed, Telescoped, Natural Development, Open Hole, Other  
**10 GAL. SAND**

WELL GROUTED TO A DEPTH OF **10** FEET  
Type Grout (circle one): **Cement**, Bentonite, or Mix

LOG DATA

TYPE OF LOG RUN (Circle One):  
No Log Run, Electric, Gamma Ray, Density, Sonic, Neutron, Other (Describe)

Name of Organization Running Log

GEOLOGIC DATA (Office Use Only)

Surface Elev.	Geologic Unit	Unit Thickness	Depth to Top
Subs. SWL	Date	Analysis	Aquifer Test

Driller's Remarks

SCREEN DATA

Diameter - Inches <b>4"</b>	Length - Feet <b>10'</b>	Slot Size - Inches <b>10 Thds.</b>
Screen Type <b>PVC</b>	Depth to Bottom - Feet <b>120</b>	

Top of Lap Pipe or Reduction in Casing

FEET IF TELESKOPED OR MORE THAN ONE SCREEN: USE BACK PAGE

DESCRIPTION OF FORMATIONS ENCOUNTERED	FROM	TO
<b>CLAY</b>	<b>0</b>	<b>15</b>
<b>SAND</b>	<b>15</b>	<b>60</b>
<b>SAND + GRAVEL</b>	<b>60</b>	<b>120</b>

FORMATIONS (Continued) FROM TO

**RECEIVED**


**SEP 23 1997**

Dept. of Environmental Quality  
Office of Land & Water Resources

IF MORE SPACE IS NEEDED, USE BACK

If well telescopes please  
sketch and show depths.

GROUND LEVEL

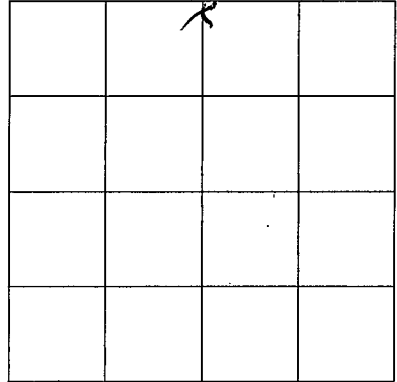

SECTION 28

Please indicate well location X.

ADDITIONAL INFORMATION

If more than one screen,  
show location of each on sketch.