

MISSISSIPPI DEPARTMENT OF ENVIRONMENTAL QUALITY

Office of Land and Water Resources

P. O. Box 10631
Jackson, MS 39289-0631
WATER WELL DRILLERS LOG

COUNTY/WELL LOCATED <u>Walshaw</u>	
WELL NUMBER <u>D 2081</u>	CODED
DATE WELL COMPLETED <u>3-23-99</u>	

PERMIT NUMBER
NAME OF DRILLING FIRM <u>Fitzgerald Well</u>

NAME & MAILING ADDRESS OF LANDOWNER <u>Earnest Pitman</u>			
<u>Percy Pitman Rd., Tylertown,</u>			
WELL LOCATION:	SEC <u>15</u>	TOWNSHIP <u>3</u>	RANGE <u>11</u>
DISTANCE <u>3</u> Miles	DIRECTION <u>East</u>	NEAREST TOWN <u>Salem</u>	
OTHER LANDMARK			
WELL PURPOSE: Home, Irrigation, Municipal, Industrial, Fish Pond, etc. <u>Chicken House</u>			

PUMP DATA		
PUMP TYPE (Circle One): <u>Submersible</u> Turbine, Jet, Flowing Well, Other (Describe)		
POWER TYPE (Circle One): <u>Electric</u> Tractor, Diesel, Gasoline, Butane, Other (Describe) H/P <u>2</u>		
Pump Capacity (GPM) <u>28</u>	No. of Stages	Setting Depth <u>110'</u> FT.
PUMP TEST		
Well yielded _____ GPM with a drawdown of _____ ft. after _____ hours of pumping		

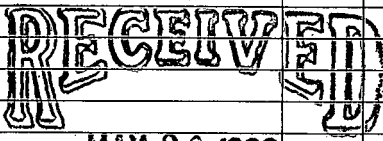
WELL DATA		
Well Depth <u>150'</u>	Casing Diameter (In.) <u>4"</u>	Casing Length (Ft.) <u>130'</u>
Type of Casing <u>PVC</u>	Hole Depth <u>150'</u>	Depth to Static Water Level <u>63'</u>
TYPE OF COMPLETION: (Circle One or More): <u>Gravel Packed</u> Underreamed, Telescoped, Natural Development, Open Hole, Other (Describe)		

LOG DATA	
TYPE OF LOG RUN (Circle One): <u>No Log Run</u> , Electric, Gamma Ray, Density, Sonic, Neutron, Other (Describe)	
Name of Organization Running Log	

WELL GROUTED TO A DEPTH OF <u>10</u> FEET Type Grout (circle one): Cement, Bentonite, or <u>Mix</u>
--

GEOLOGIC DATA (Office Use Only)			
Surface Elev.	Geologic Unit	Unit Thickness	Depth to Top
Subs. SWL	Date	Analysis	Aquifer Test
Driller's Remarks			
Top of Lap Pipe or Reduction in Casing			
FEET IF TELESCOPED OR MORE THAN ONE SCREEN: USE BACK PAGE			

SCREEN DATA		
Diameter - Inches <u>4"</u>	Length - Feet <u>20</u>	Slot Size - Inches <u>.010</u>
Screen Type <u>PVC</u>	Depth to Bottom - Feet <u>150'</u>	

DESCRIPTION OF FORMATIONS ENCOUNTERED	FROM	TO	FORMATIONS (Continued)	FROM	TO
<u>Top soil</u>	<u>0</u>	<u>5</u>	 <u>MAY 26 1999</u> Dept. of Environmental Quality Office of Land & Water Resources		
<u>clay</u>	<u>5</u>	<u>30</u>			
<u>Sand</u>	<u>30</u>	<u>50</u>			
<u>clay</u>	<u>80</u>	<u>100</u>			
<u>Sand</u>	<u>100</u>	<u>130</u>			
<u>course sand</u>	<u>130</u>	<u>150</u>			

IF MORE SPACE IS NEEDED, USE BACK

If well telescopes please
sketch and show depths.

GROUND LEVEL

X			

SECTION _____

Please indicate well location X.

ADDITIONAL INFORMATION

If more than one screen,
show location of each on sketch.