

WALTHALL
E
5-27-74

MISSISSIPPI
 BOARD OF WATER COMMISSIONERS **CODED**
 416 North State Street
 Jackson, Mississippi 39201
WATER WELL DRILLERS LOG

5/27 1974 Earley Slotted Water Well Walthall County
 date well completed firm name county well located

LANDOWNER: Benton Bravellette
Jylertown, Mississippi
 (mailing address)

description of formations encountered	from	to
topsoil topsoil	0	2
chalk	2	20
sand & gravel	20	76

WELL LOCATION:
 sec. 35 T. 66 N. R. 10 E.
1 miles south of Jylertown
 (distance) (direction) (nearest town)

WELL PURPOSE: home
 (home, irrigation, municipal, industrial)

- WELL COMPLETION DATA:
- (1) diameter (inches) 4"
 - (2) total depth (feet) 76'
 - (3) static water level (feet) 19' below above top of ground.
 - (4) casing 4" 66'
 (material) (depth)
 - 4"
 (size) If telescope see back.
 - (5) screen 10ft 66
 (length) (depth to top)
 - 4" plastic
 (size) (material)
 - (6) pump 1/2 350 gal per hr
 (HP) (yield gpm)
 - Elec.
 (type power)
 - (7) electric log (yes or no)
 - (organization running log)
 - (8) how well bottom plugged B.W.V.

CODED

RECEIVED
RECEIVED


AUG - 5 1974

DRILLERS REMARKS:
Clive Duncan

MISS. BD. OF WATER COMM

If well telescopes please sketch and show depths.

GROUND LEVEL

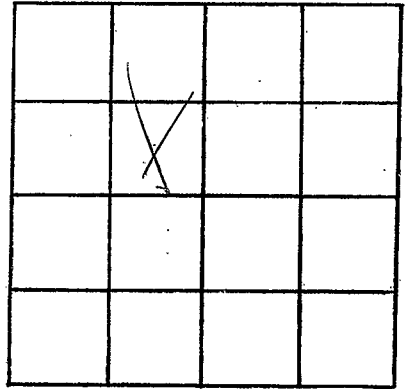

SECTION _____

Please indicate well location X.

ADDITIONAL INFORMATION

If more than one screen, show locations of each on sketch.