

WALTHAM

E

6-14-74

MISSISSIPPI BOARD OF WATER COMMISSIONERS
416 North State Street
Jackson, Mississippi 39201

CODED

WATER WELL DRILLERS LOG

6/14/74 date well completed
Easley Stopper Water Well firm name
Waltham Co county well located

LANDOWNER: Hubert Magee

Iylertown, Miss

(mailing address)

WELL LOCATION:

sec 23 T 2 N R 10 E

1 miles West of Iylertown
(distance) (direction) (nearest town)

WELL PURPOSE: home
(home, irrigation, municipal, industrial)

WELL COMPLETION DATA:

- (1) diameter (inches) 4"
- (2) total depth (feet) 105
- (3) static water level (feet) 80 below top of ground.
- (4) casing 4" (material) 95 (depth)
- 4" (size) if telescope see back.
- (5) screen 10' (length) 95' (depth to top)
- 4" (size) plastic (material)
- (6) pump 1/2 hp (HP) 10 (yield gpm)
- Elex (type power)
- (7) electric log (yes or no)

(organization running log)


(8) how well bottom plugged B.W.U.

DRILLERS REMARKS:

Clerve D...

description of formations encountered	from	to
top soil	0	4
clay gravel	5	30
chalk	31	70
sand & gravel	71	105

CODED

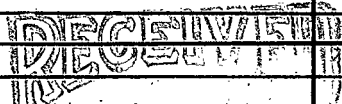

JUN - 5 1974

