

WALTHALL
E
12-13-73

MISSISSIPPI
 BOARD OF WATER COMMISSIONERS
 416 North State Street
 Jackson, Mississippi 39201

CODED

WATER WELL DRILLERS LOG

Dec 13 19 73 Chester Keener Walthall
 date well completed firm name county well located

LANDOWNER: Jerry Johnston
RT 4, Tylertown
 (mailing address)

WELL LOCATION:
 sec 6 T 2 N R 10 E
7 miles W of Tylertown
 (distance) (direction) (nearest town)

WELL PURPOSE: Home
 (home, irrigation, municipal, industrial)

- WELL COMPLETION DATA:
- (1) diameter (inches) 4"
 - (2) total depth (feet) 154'
 - (3) static water level (feet) 89' below top of ground.
 - (4) casing Cast, Galv
 (material) (depth)
 - _____ if telescope see back.
 (size)
 - (5) screen 6' 148'
 (length) (depth to top)
4" Plast
 (size) (material)
 - (6) pump 3/4 sub 15
 (HP) (yield gpm)
fleet
 (type power)
 - (7) electric log no
 (yes or no)
 - _____ (organization running log)

description of formations encountered	from	to
Red clay	0	22
Red sand	22	83
Sand & gravel	83	97
Red white chalk	97	138
Peagranul sand	138	154

CODED


RECEIVED
MAY 24 1974

MISS. BD. OF WATER COMMISSIONERS

(8) how well bottom plugged: wooden plug
 DRILLERS REMARKS: old 2" well had

If well telescopes please sketch and show depths.

GROUND LEVEL

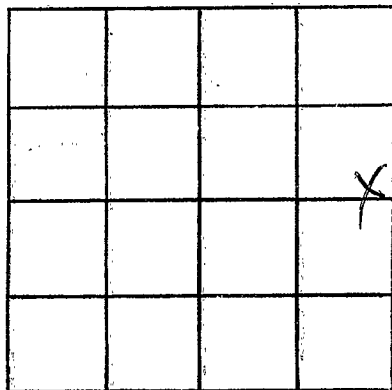

SECTION 6

Please indicate well location X.

ADDITIONAL INFORMATION

If more than one screen, show locations of each on sketch.