

WALTHALL

E

5-11-73

MISSISSIPPI BOARD OF WATER COMMISSIONERS 416 North State Street Jackson, Mississippi 39201

CODED

WATER WELL DRILLERS LOG

date well completed: May 11 1973 firm name: Chester Reeves county well located: Walthall

LANDOWNER: Douglas P. Bell RFD - Tylertown

Description of formations encountered	from	to
Red Clay	0	22
Red Sand	22	55
Chalk	68	73
Sand & gravel	73	84

(mailing address)

WELL LOCATION: sec. 15 T 2 N R 10 E 3 miles NW of Tylertown

CODED

WELL PURPOSE: Farm (home, irrigation, municipal, industrial)

- WELL COMPLETION DATA:
- (1) diameter (inches) 4"
  - (2) total depth (feet) 96
  - (3) static water level (feet) 56 below top of ground
  - (4) casing: Plast bottom (material) (depth)
  - (5) screen: 6' 88' (length) (depth to top) 4" Plast (size) (material)
  - (6) pump: 1/2 HP 12 (type power) (yield gpm)
  - (7) electric log: NO (yes or no)
  - (organization running log)


(8) how well bottom plugged: wood plug

DRILLERS REMARKS: New hand

RECORDED MAY 24 1974

If well telescopes please sketch and show depths.

GROUND LEVEL

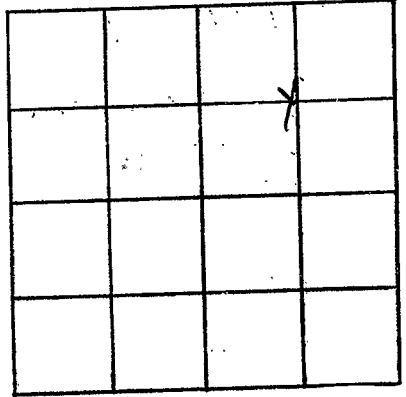

SECTION         

Please indicate well location X.

ADDITIONAL INFORMATION

If more than one screen, show locations of each on sketch.