

~~Ralph~~
~~Cotton's~~
~~Water Well~~
~~Drilling~~

Wattkall
 E

MISSISSIPPI
 BOARD OF WATER COMMISSIONERS
 416 North State Street
 Jackson, Mississippi 39201

WATER WELL DRILLERS LOG

December 1983 R. Cotton's Drilling Wattkall
 date well completed firm name county well located

LANDOWNER: Miss. Kennedy
Jylentown, Miss.
next to Walker's Bridge
on Jy. & Main
 (mailing address)
 WELL LOCATION:
 1/4 Sec. 1 N. 1/4 E.
 1/4 S. 1/4 W.

description of formations encountered	from	to
20 ft. sand & gravel		
blue clay	20-	120ft
40 ft. of blue flow sand		
Complete well		160ft.

(distance) miles (direction) of (nearest town)

WELL PURPOSE:
 (home, irrigation, municipal, industrial)

WELL COMPLETION DATA:

- (1) diameter (inches) 2 in.
- (2) total depth (feet) 160 ft.
- (3) static water level (feet) flow well above top of ground
- (4) casing P.V.C. 160
 (material) (depth)
 (size) if telescope see back.
- (5) screen 20 ft. 160 ft. well
 (length) (depth to top)
2 in. plastic
 (size) (material)
- (6) pump flow well
 (HP) (yield gpm)
 (type power)
- (7) electric log no
 (yes or no)
 (organization running log)
- (8) how well bottom plugged 2 in. val.

DRILLERS REMARKS: Good flow well
2 in. pipe


DEPT. OF NATURAL RESOURCES
 BOARD OF LAND & WATER RESOURCES

JAN 23 1984

RECEIVED

If well telescopes please sketch and show depths.

GROUND LEVEL

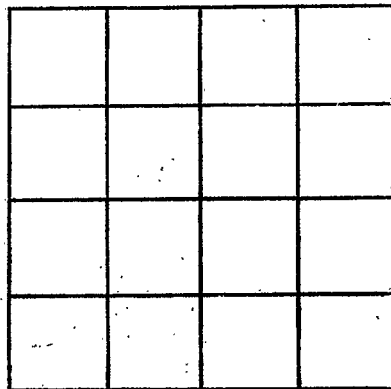

SECTION _____

Please indicate well location X.

ADDITIONAL INFORMATION

If more than one screen,
show locations of each on sketch.