

CODED

Walthall
E13
9-10-68

MISSISSIPPI
BOARD OF WATER COMMISSIONERS
416 North State Street
Jackson, Mississippi 39201

WATER WELL DRILLERS LOG

9-10 1968 Zuke Fitzgerald Well Walthall
date well completed firm name county well located

LANDOWNER: Zuke Magee

description of formations encountered	from	to

R.R. Tylertown Miss.
(mailing address)

Top soil & Red clay	0	10
Coarse sand & gravel	10	50
white clay	50	70
Coarse sand & gravel	70	103

WELL LOCATION:
sec. 1 T. 2 N. R. 9 E.
6 miles NW of Tylertown
(distance) (direction) (nearest town)


WELL PURPOSE: Home
(home, irrigation, municipal, industrial)

WELL COMPLETION DATA:

- (1) diameter (inches) 4
- (2) total depth (feet) 103
- (3) static water level (feet) 25 below top of ground.
- (4) casing Plastic, 97 (material) (depth)
4 (size) If telescope see back.
- (5) screen 6, 97 (length) (depth to top)
4 (size) Plastic (material)
- (6) pump 3, 7 (HP) (yield gpm)
Elin (type power)
- (7) electric log (yes or no)
- (organization running log)


(8) how well bottom plugged gravel

DRILLERS REMARKS:

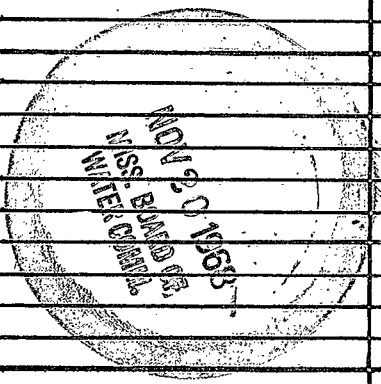

If well telescopes please sketch and show depths.

GROUND LEVEL

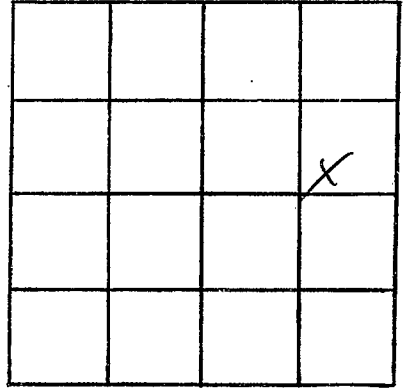

SECTION /

Please indicate well location X.

ADDITIONAL INFORMATION

If more than one screen, show locations of each on sketch.