

600 CODED

Walthall
E15
11-19-68

MISSISSIPPI
BOARD OF WATER COMMISSIONERS
416 North State Street
Jackson, Mississippi 39201

WATER WELL DRILLERS LOG

11-19-1968 date well completed
Ed Fitzgerald Water Well Drilling firm name
Walthall county well located

LANDOWNER: Albert Lang
Tylertown, RT 4 MISS
(mailing address)

description of formations encountered	from	to
Red clay & top soil	0	22
Red sand	22	60
Chalky	60	80
Fine sand	80	95
gravel	95	98
Chalk	98	105
Perfect Aquifer	105	126

WELL LOCATION:
sec 23 T 2 N R 18 E S
2 miles W of Tylertown
(distance) (direction) (nearest town)

WELL PURPOSE: home
(home, irrigation, municipal, industrial)


- WELL COMPLETION DATA:
- (1) diameter (inches) 4
 - (2) total depth (feet) 126
 - (3) static water level (feet) 85 below top of ground.
 - (4) casing plastic, 120
(material) (depth)
4 if telescope see back.
(size)
 - (5) screen 6', 120
(length) (depth to top)
4, sch 40
(size) (material)
 - (6) pump 1 HP, 10
(HP) (yield gpm)
Elec
(type power)
 - (7) electric log no
(yes or no)
 - (organization running log)
 - (8) how well bottom plugged Wadpeg

DRILLERS REMARKS:

MISS. Bd. of
WATER COMMISSIONERS

If well telescopes please sketch and show depths.

GROUND LEVEL

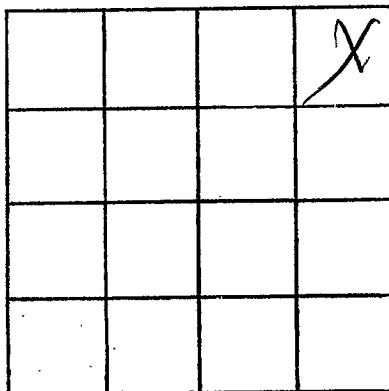

SECTION 23

Please indicate well location X.

ADDITIONAL INFORMATION

If more than one screen, show locations of each on sketch.