

E LOG # 60

MISSISSIPPI
BOARD OF WATER COMMISSIONERS
416 North State Street
Jackson, Mississippi 39201

CODED

WALTHALL

E 17

Water Well # 1

3-71

WATER WELL DRILLERS LOG

March 19 71 Leiner Drilling Service Walthall

date well completed

firm name

county well located

~~BOARD OF SUPERVISORS~~

LANDOWNER: WALTHALL

County Industrial Park

Tylertown, Miss
(mailing address)

WELL LOCATION:

sec. 22 T 20 N R 100 E
S W
3 miles SW of Tylertown
(distance) (direction) (nearest town)

WELL PURPOSE:

(home, irrigation, municipal, industrial)

WELL COMPLETION DATA:

- (1) diameter (inches) 10 3/4"
- (2) total depth (feet) 458'
- (3) static water level (feet) 100 below above top of ground.
- (4) casing Steel, 400'
(material) (depth)
10 3/4" if telescope see back.
(size)
- (5) screen 50', 408'
(length) (depth to top)
8 5/8, 304 S.S.
(size) (material)
- (6) pump 40 500
(HP) (yield gpm)
Elec
(type power)
- (7) electric log yes
(yes or no)
M LFS.
(organization running log)

(8) how well bottom plugged Back
WASH Valve

description of formations encountered	from	to
Top Soil	0	2
Clay	2	12
SAND & GRAVEL	12	62
Clay	62	78
SAND & GRAVEL	78	208
Clay	208	290
Fine Sand	290	330
Clay	330	406
SAND	406	458
Clay	458	510
SAND	510	523

CODED

MAR 5 1971


MISS. BD. OF
WATER COMM.

DRILLERS REMARKS:

D

If well telescopes please sketch and show depths.

GROUND LEVEL

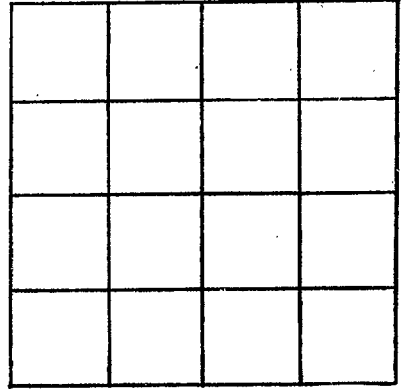

SECTION _____

Please indicate well location X.

ADDITIONAL INFORMATION

If more than one screen, show locations of each on sketch.