

E18

4-6-61

WATER WELL DRILLERS LOG

Date: April 6, 1961, Driller: S. S. Rouse County: Waltham

WRIGHT HARVEY  
(Name)

(1) Owner of Land: Wright Harvey  
(Name)

Tylertown Mess.  
(Address) 22 2N-10E

(2) Location: 1/4, 1/4, Sec. T R

5 miles West of Tylertown  
(distance) (direction) (Nearest Town)

(3) Topography: Hilly  
(Hilly) (Flat) (Level)

(4) Purpose of Well: Domestic  
(Domestic Irrigation, Municipal, Industrial, Other)

Description & Color of Materials Sand, Clay, Red Clay, Shell, etc.	Thick- ness Feet	Depth Feet
<u>21 Red sand</u>		
<u>21 Red sand</u>		
<u>21 =</u>		
<u>21 =</u>		
<u>21 =</u>		
<u>21 clay</u>		
<u>21 clay</u>		
<u>21 clay</u>		
<u>21 clay</u>		
<u>21 water sand</u>		

Information upon completion of well:

(1) Diameter 2 inches.

(2) Total Depth 210 feet.

(3) Water Level 190 feet below top of ground.

(4) Cased to 20 5, Size 2 inch

(5) Screen: Size 1/2 inch, Length 5 feet


(6) Were any formations sealed against pollution?

no

If YES depth of formation \_\_\_\_\_

Why \_\_\_\_\_

Drillers Remarks: \_\_\_\_\_

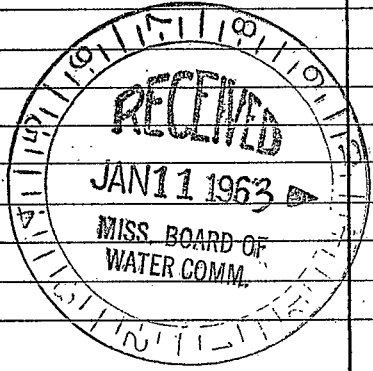

(Use Back Side)

Well No.

Miss