

WALTHALL

E 21

5-13-71

MISSISSIPPI BOARD OF WATER COMMISSIONERS
416 North State Street
Jackson, Mississippi 39201

CODED

WATER WELL DRILLERS LOG

5-13

date well completed

1971

firm name

Walthall
county well located

LANDOWNER:

Miss. Bapt. Church

R.R. Tylston
(mailing address)

description of formations encountered

from

to

Red Clay 0 20
Red Soil & gravel 20 110
Coarse Sand & gravel 110 126

WELL LOCATION:

sec. 9 T 20 N R 1 E
3 miles W of Tylston
(distance) (direction) (nearest town)

WELL PURPOSE: Home
(home, irrigation, municipal, industrial)

WELL COMPLETION DATA:

- (1) diameter (inches) 4
- (2) total depth (feet) 134
- (3) static water level (feet) 95 below top of ground.
- (4) casing 4" (material) (depth)
4" (size) if telescope see back.
- (5) screen 8" (length) 126 (depth to top)
4" (size) (material)
- (6) pump 3/4 (HP) 12 (yield gpm)
Electric (type power)
- (7) electric log (yes or no)
- (organization running log)
- (8) how well bottom plugged wood per

CODED


JUN 14 1971

DRILLERS REMARKS:

MISS. BD. OF
WATER COMM.

If well telescopes please sketch and show depths.

GROUND LEVEL

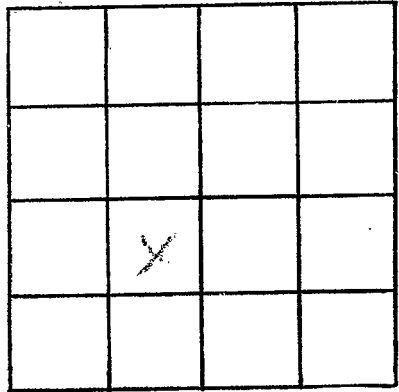

SECTION 9

Please indicate well location X.

ADDITIONAL INFORMATION

If more than one screen, show locations of each on sketch.