

WALTHALL

E 24
3-21-66

CODED

MISSISSIPPI BOARD OF WATER COMMISSIONERS
WATER WELL DRILLERS LOG

Date: 3/21, 1966, Driller: T. B. Andrews County Walthall

(Name)

(1) Owner of Land: A. J. Rayborn Jr.
(Name)

Rt. 4 Tyler town Miss
(Address)

(2) Location: 1/4, 1/4, Sec. 11 T2R10

8 miles N.W. of Tyler town
(distance) (direction) (Nearest Town)

(3) Topography: Hilly
(Hilly) (Flat) (Level)

(4) Purpose of Well: Domestic
(Domestic Irrigation
Municipal, Industrial, Other)

Description & Color of Materials
Sand, Clay, Red Clay, Shell, etc.

Thick-
ness
Feet

Depth
Feet

Sand from
0' to 60'

60' to 80'
Red Clay

80' to 90'
Red Chalk

90' to 111'
Sandy Red Clay

111' to 117'
Gravel

Information upon completion of well:

(1) Diameter 6 1/4 inches.

(2) Total Depth 117' feet.

(3) Water Level 97' feet below top of ground.

(4) Cased to 117', Size 4"

(5) Screen: Size works, Length ✓


(6) Were any formations sealed against pollution?

no ✓

If YES depth of formation _____

Why _____

Drillers Remarks: _____

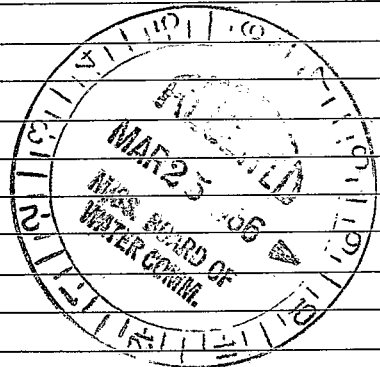

(Use Back Side)

Well No. _____

1870

1871

1872

1900