

WALTHAM MISSISSIPPI BOARD OF WATER COMMISSIONERS

E 26  
4-20-66 CODED

WATER WELL DRILLERS LOG

Date: 4/20, 1966, Driller: T. B. Andrews County Waltham  
(Name)

(1) Owner of Land: Ed Craft  
(Name)  
Tuletown, Miss  
(Address)

(2) Location: 1/4, 1/4, Sec. 23 T. 2 R. 10  
1/4 miles W, of Tuletown  
(distance) (direction) (Nearest Town)

(3) Topography: Hilly  
(Hilly) (Flat) (Level)

(4) Purpose of Well: Domestic  
(Domestic Irrigation  
Municipal, Industrial, Other)

Description & Color of Materials Sand, Clay, Red Clay, Shell, etc.	Thick- ness Feet	Depth Feet
" 0' to 30' Red Clay		
30' to 45' GRAVEL		
45' to 60' sand		
60' to 70' Sand / fine gravel		

Information upon completion of well:

(1) Diameter 2 inches.

(2) Total Depth 70 feet.

(3) Water Level 48 feet below top of ground.

(4) Cased to 70', Size 2"


(5) Screen: Size 2", Length 5'

(6) Were any formations sealed against pollution?  
\_\_\_\_\_ yes, \_\_\_\_\_  no.

If YES depth of formation \_\_\_\_\_  
Why \_\_\_\_\_

Drillers Remarks:  
Galvanized pipe well

CODED

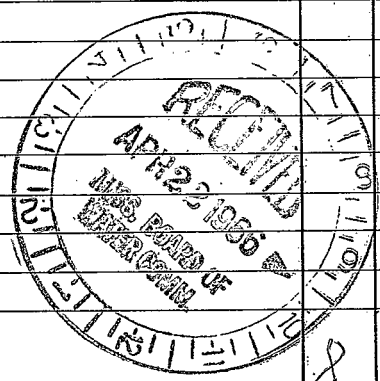

(Use Back Side)

Well No. 8

