

WALTHALL MISSISSIPPI BOARD OF WATER COMMISSIONERS


E-27

6-13-66

WATER WELL DRILLERS LOG

Date: 6/13, 1966, Driller: T.B. Andrews County Walthall  
 (Name)

	Description & Color of Materials Sand, Clay, Red Clay, Shell, etc.	Thick- ness Feet	Depth Feet
(1) Owner of Land: <u>E.W. Smet</u> (Name) <u>Mesa, Mississippi</u> (Address)	0' to 35' Red Clay		
(2) Location: <u>9 2-10</u> <u>4</u> miles <u>W</u> of <u>Theriot</u> (distance) (direction) (Nearest Town)	35' to 85' Sand / gravel		
(3) Topography: <u>Hilly</u> (Hilly) (Flat) (Level)			
(4) Purpose of Well: <u>Domestic</u> (Domestic Irrigation Municipal, Industrial, Other)	85' to 120' Sand		
Information upon completion of well:			
(1) Diameter <u>4</u> inches.	120' to 130' per gravel Sand		
(2) Total Depth <u>130</u> feet.			
(3) Water Level <u>90</u> feet below top of ground.			
(4) Cased to <u>130'</u> , Size <u>4"</u>			
(5) Screen: Size <u>4"</u> , Length <u>6</u>			
(6) Were any formations sealed against pollution? <u>yes</u> , <input checked="" type="checkbox"/> <u>no</u> .			
If YES depth of formation _____			
Why _____			
Drillers Remarks: _____			
<u>Plastic Well</u>			

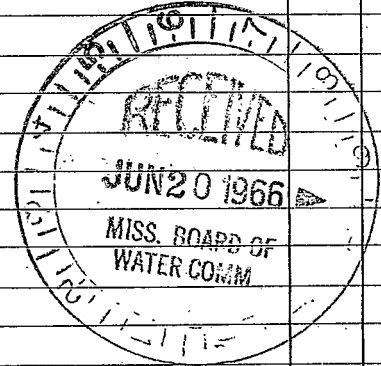

(Use Back Side)

Well No.

