

E 28

6-22-66

CODED

WATER WELL DRILLERS LOG

Date: 6/22, 1966, Driller: F.B. Andrews County Walthall

(Name)

(1) Owner of Land: Ed Craft (Name)

Mesa, Mississippi (Address)

(2) Location: 1/4, 1/4, Sec. 9 T2R10

4 miles W of Tylertown (distance) (direction) (Nearest Town)

(3) Topography: Hilly (Hilly) (Flat) (Level)

(4) Purpose of Well: Domestic (Domestic Irrigation Municipal, Industrial, Other)

Description & Color of Materials Sand, Clay, Red Clay, Shell, etc.

Thickness Feet

Depth Feet

0' to 35' Red Clay

35' to 85' Sand/gravel

85' to 120' Sand pos gravel

Information upon completion of well:

(1) Diameter 2 inches.

(2) Total Depth 120 feet.

(3) Water Level 75' feet below top of ground.

(4) Cased to 120, Size 2"

(5) Screen: Size 2", Length 5'

(6) Were any formations sealed against pollution?

yes, no. [checked]


If YES depth of formation

Why

Drillers Remarks:

Dechlorinated well

CODED

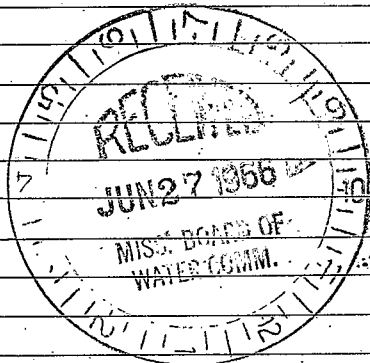

(Use Back Side)

Well No.

100-100000-100000

100