

Walshall

E 31

11-66

MISSISSIPPI BOARD OF WATER COMMISSIONERS

CODED

WATER WELL DRILLERS LOG

Date: Nov 15, 1966, Driller: Vic Fitzgerald County Walshall

(When well drilled)

(Name)


(Where well is located)

1) Owner of Land: Clifton Baughtman
P.O. Box 11, Tylertown, Miss
2) Location: NW 1/4, NE 1/4, Sec. 22 T2R10
1 miles W of Tylertown
3) Topography: X (Hilly)
4) Purpose of Well: Domestic

Table with 3 columns: Description & Color of Materials, Thickness Feet, Depth Feet. Rows include: Reel clay (20 ft), Reel sand (40 ft), Coarse sand gravel (10 ft), Reel silted gravel (15 ft), Coarse sand gravel (15 ft).

Information upon completion of well:
Diameter 4 inches
Total Depth 100 feet
Water Level 60 feet below top of ground
Cased to 92, Size 4"
Screen: Size 4", Length 8'
Were any formations sealed against pollution? yes, X no.
YES depth of formation
Remarks
Yield in gpm: 40 gpm
Type pump:
Type power: elec

CODED

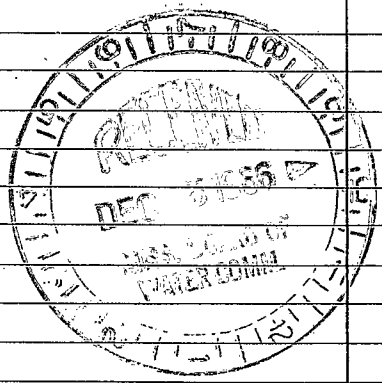

Send this copy to Board of Water Commissioners 429 Miss. St. Jackson, Miss.

