

**MISSISSIPPI  
BOARD OF WATER COMMISSIONERS**  
416 North State Street  
Jackson, Mississippi 39201

Walthall

E 32

1-67

**CODED**

**WATER WELL DRILLERS LOG**

Jan. 23 1967  
date well completed

Andy's Drilling Co.  
firm name

Walthall  
county well located

LANDOWNER: Vincent Beuletta

description of formations encountered	from	to

Rt. 6 Tubertown  
Miss.  
(mailing address)

<u>gessy clay</u>	<u>0'</u>	<u>20'</u>
-------------------	-----------	------------

**WELL LOCATION:**

sec. 2 T. 2 N. R. 10 E.  
1 miles SW of Tubertown  
(distance) (direction) (nearest town)

<u>Sand gravel</u>	<u>20'</u>	<u>60'</u>
--------------------	------------	------------

<u>Blue shale</u>	<u>60'</u>	<u>280'</u>
-------------------	------------	-------------

<u>Coarse sand</u>	<u>280'</u>	<u>320'</u>
--------------------	-------------	-------------

WELL PURPOSE: Home  
(home, irrigation, municipal, industrial)

**WELL COMPLETION DATA:**

(1) diameter (inches) 2"

(2) total depth (feet) 320'

(3) static water level (feet) — below above top of ground.

(4) casing galv. 315'  
(material) (depth)

2"  
(size) If telescope see back.

(5) screen 5' 320'  
(length) (depth to top)

2" Stainless Steel  
(size) (material)

(6) pump 6  
(HP) (yield gpm)

(type power)

(7) electric log no  
(yes or no)


(organization running log)

(8) how well bottom plugged Back  
Wash Drive

DRILLERS REMARKS:


Flooding (Small flow)

**CODED**

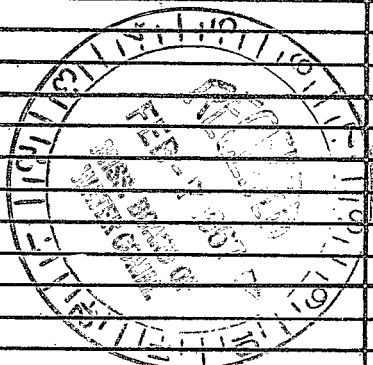

If well telescopes please sketch and show depths.

GROUND LEVEL

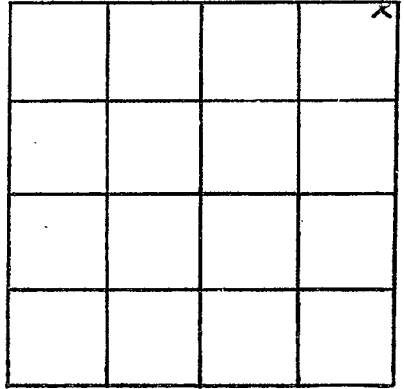

SECTION 36

Please indicate well location X.

ADDITIONAL INFORMATION

No one is living  
at this place at  
the present time  
Mr. Bouchette is in  
New Orleans - They  
come over on  
week-end to fix  
the place up.  
at the present time  
No pump or anything  
is put on the well  
T.P.P.

If more than one screen,  
show locations of each on sketch.