

**MISSISSIPPI
BOARD OF WATER COMMISSIONERS**
416 North State Street
Jackson, Mississippi 39201

WATER WELL DRILLERS LOG

Walthall
E33
3-67

CODED

Mar 16 1967 Fitzgerald Well Drilling Walthall
date well completed firm name county well located

LANDOWNER: Shirley Crawford

description of formations encountered	from	to
<u>Red clay</u>	<u>0</u>	<u>25</u>
<u>Red sand</u>	<u>25</u>	<u>65</u>
<u>Red sand & gravel</u>	<u>65</u>	<u>120</u>
<u>Coarse sand</u>	<u>120</u>	<u>125</u>
<u>Coarse sand & gravel</u>	<u>125</u>	<u>135</u>

Rt. Tylustown Miss
(mailing address)


WELL LOCATION:
sec. 29 T 2 N R. 10 E
7 miles West of Tylustown
(distance) (direction) (nearest town)

WELL PURPOSE: Home
(home, irrigation, municipal, industrial)

WELL COMPLETION DATA:

- (1) diameter (inches) 4
- (2) total depth (feet) 135
- (3) static water level (feet) 90 below top of ground.
- (4) casing Plastic 127
(material) (depth)
4" if telescope see back.
(size)
- (5) screen 8' 127
(length) (depth to top)
4" Plastic
(size) (material)
- (6) pump 1 5 8
(HP) (yield gpm)
- Electric
(type power)
- (7) electric log No
(yes or no)
(organization running log)
- (8) how well bottom plugged wood peg

CODED

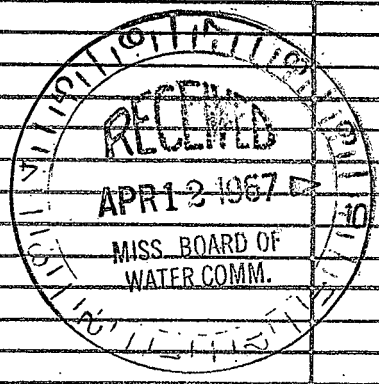

DRILLERS REMARKS:

If well telescopes please sketch and show depths.

GROUND LEVEL

	X		

SECTION 29

Please indicate well location X.

ADDITIONAL INFORMATION

If more than one screen, show locations of each on sketch.