

MISSISSIPPI  
 BOARD OF WATER COMMISSIONERS  
 416 North State Street  
 Jackson, Mississippi 39201

WATER WELL DRILLERS LOG

Walshall  
 E 34  
 3-67

CODED

3/16 1967 date well completed by Andy Drilling Co. firm name Walshall county well located

LANDOWNER: Verdon Craft

description of formations encountered

from to

Rt. 4  
Tylertown, Miss.  
 (mailing address)

Red clay 0' 20'

WELL LOCATION:

sec. B T 2 N R 10 E  
3 1/2 miles n.w. of Tylertown  
 (distance) (direction) (nearest town)

Green clay 20' 40'

WELL PURPOSE: Home  
 (home, irrigation, municipal, industrial)

Sand / gravel 40' 45'

WELL COMPLETION DATA:

(1) diameter (inches) 4"

(2) total depth (feet) 90'

(3) static water level (feet) 40 below top of ground.

(4) casing P.V.C. 84'  
 (material) (depth)

4" If telescope see back.  
 (size)

(5) screen 6' 84'  
 (length) (depth to top)

4" P.V.C.  
 (size) (material)

(6) pump \_\_\_\_\_ (HP) \_\_\_\_\_ (yield gpm)

(type power)

(7) electric log no  
 (yes or no)

(organization running log)


(8) how well bottom plugged Back  
Wash

Chalk 45' 55'

Sand 55' 80'

Coarse Sand / gravel 80' 90'

CODED

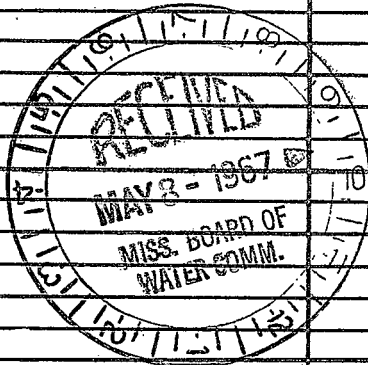


DRILLERS REMARKS:

Mr. Craft Just

If well telescopes please sketch and show depths.

GROUND LEVEL

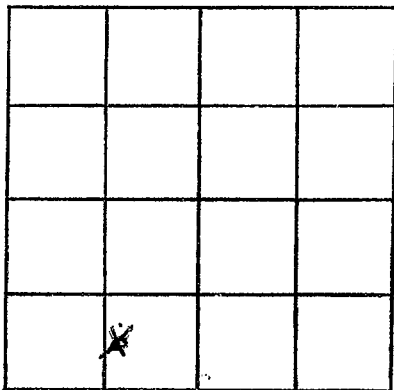

SECTION 13

Please indicate well location X.

ADDITIONAL INFORMATION

bought the form  
There was no power.  
When well was  
drilled - Did not  
install pump.

If more than one screen,  
show locations of each on sketch.