

Waltham  
E35  
4-67

CODED

MISSISSIPPI  
BOARD OF WATER COMMISSIONERS  
416 North State Street  
Jackson, Mississippi 39201

WATER WELL DRILLERS LOG

4/10 1967 Andy's Drilling Co. Waltham  
date well completed firm name county well located

LANDOWNER: Mrs. Hope  
Drumfield Rt. 4  
Tupelo, Miss.  
(mailing address)

description of formations encountered	from	to
Chalk	0'	20'
Sand/gravel	20'	40'
Blue Clay	40'	120'
Sand	120'	158'


WELL LOCATION:  
sec. 24 T. 2 N. R. 9 E  
S W  
6 1/2 miles W of Tupelo  
(distance) (direction) (nearest town)

WELL PURPOSE: Home  
(home, irrigation, municipal, industrial)

WELL COMPLETION DATA:

- (1) diameter (inches) 2"
- (2) total depth (feet) 158'
- (3) static water level (feet) 40' below top of ground.
- (4) casing galv., 153' (material) (depth)  
2" (size) If telescope see back.
- (5) screen 5", 153' (length) (depth to top)  
2", Stainless Steel (size) (material)
- (6) pump 10 (HP) (yield gpm)  
220 (type power)
- (7) electric log NO (yes or no)  
(organization running log)
- (8) how well bottom plugged Bank Wash Valve


CODED

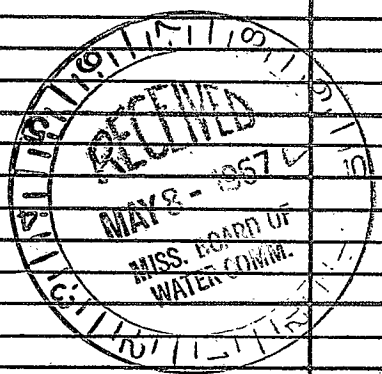

DRILLERS REMARKS:  
Did not install pump

If well telescopes please sketch and show depths.

GROUND LEVEL

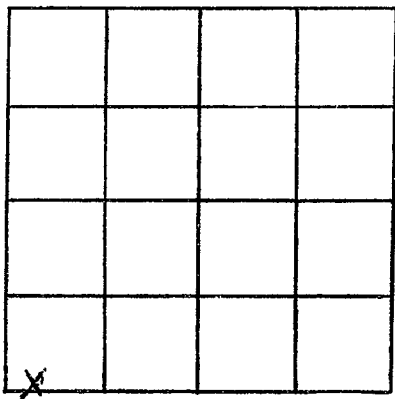

SECTION 24

Please indicate well location X.

ADDITIONAL INFORMATION

If more than one screen,  
show locations of each on sketch.