

Walthall
E 36
6-67

MISSISSIPPI
BOARD OF WATER COMMISSIONERS
416 North State Street
Jackson, Mississippi 39201

WATER WELL DRILLERS LOG

6-30-1967 H. Fitzgerald Water Well Walthall
date well completed firm name county well located

LANDOWNER: A. Tedd Holmes
Rt 4 Tyler town

description of formations encountered	from	to
top silty clay	0	22
Red cherty sand	22	138
gravel sand	138	180

(mailing address)

WELL LOCATION:
sec 23 T 2 N R 10 E
2 miles West of Tyler town
(distance) (direction) (nearest town)

WELL PURPOSE: Home
(home, irrigation, municipal, industrial)

- WELL COMPLETION DATA:
- (1) diameter (inches) 4
 - (2) total depth (feet) 174
 - (3) static water level (feet) 251 below top of ground.
 - (4) casing plastic 168
(material) (depth)
 - 4 if telescope see back.
(size)
 - (5) screen 61 168
(length) (depth to top)
 - 4 plastic
(size) (material)

CODED

(6) pump _____
(HP) (yield gpm)


(type power)

(7) electric log NO
(yes or no)

(organization running log)


(8) how well bottom plugged Wood peg

DRILLERS REMARKS:

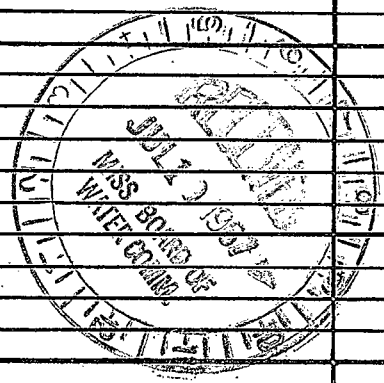

If well telescopes please sketch and show depths.

GROUND LEVEL

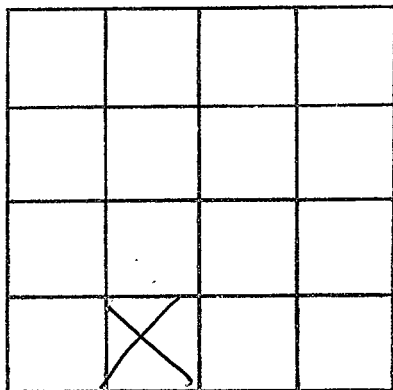

SECTION 23

Please indicate well location X.

ADDITIONAL INFORMATION

If more than one screen, show locations of each on sketch.