

Walthall
E37
9-67

MISSISSIPPI
BOARD OF WATER COMMISSIONERS
416 North State Street
Jackson, Mississippi 39201

WATER WELL DRILLERS LOG

Sept. 1 1967 Fitzgibbon & Lester Walthall
date well completed firm name county well located

LANDOWNER: Sylvester Juden

description of formations encountered	from	to
<u>Red clay</u>	<u>0</u>	<u>20</u>
<u>Coarse sand & gravel</u>	<u>20</u>	<u>60</u>
<u>Red sand</u>	<u>60</u>	<u>120</u>
<u>Coarse sand & gravel</u>	<u>120</u>	<u>134</u>

RT - Fyfeville Miss.
(mailing address)


WELL LOCATION:
sec. 29 T 2 N R 10 E
5 miles SW of Fyfeville
(distance) (direction) (nearest town)

WELL PURPOSE: Home
(home, irrigation, municipal, industrial)

WELL COMPLETION DATA:
(1) diameter (inches) 4"
(2) total depth (feet) 134'
(3) static water level (feet) 45' below top of ground.
(4) casing Plastic, 128'
(material) (depth)
4" if telescope see back.
(size)
(5) screen 6', 128'
(length) (depth to top)
4", Plastic
(size) (material)
(6) pump 1 20-
(HP) (yield gpm)
Electric
(type power)
(7) electric log No
(yes or no)

(organization running log)
(8) how well bottom plugged wood peg


CODED

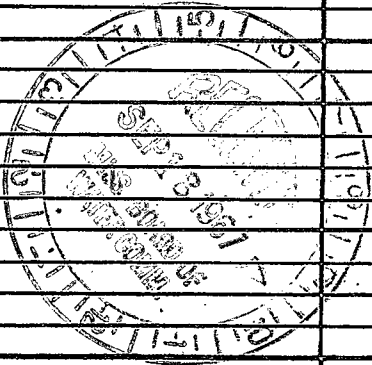

DRILLERS REMARKS:

If well telescopes please sketch and show depths.

GROUND LEVEL

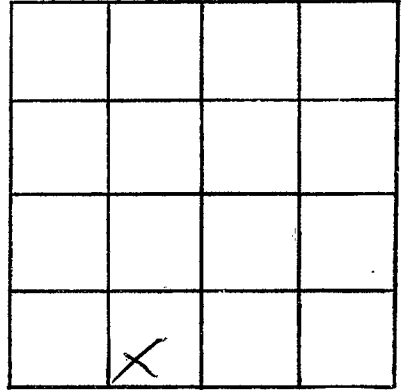

SECTION 29

Please indicate well location X.

ADDITIONAL INFORMATION

If more than one screen,
show locations of each on sketch.