

WALTHALL  
E 38  
1-67

MISSISSIPPI  
BOARD OF WATER COMMISSIONERS  
416 North State Street  
Jackson, Mississippi 39201

WATER WELL DRILLERS LOG

JAN. 26 1967 FETNER + ELLET BROWN WALTHALL  
date well completed firm name county well located

LANDOWNER:  
Mrs. O. L. Hughes  
TYLETOWN MISS.  
(mailing address)

description of formations encountered	from	to
	Red CLAY	0
SAND	15	58
GRAVEL	58	100

WELL LOCATION:  
sec. 19 T. 2 N. R. 10 E.  
5 miles W of TYLETOWN  
(distance) (direction) (nearest town)


WELL PURPOSE: Home  
(home, irrigation, municipal, industrial)

WELL COMPLETION DATA:

- (1) diameter (inches) 4"
- (2) total depth (feet) 100
- (3) static water level (feet) 81 (below/above top of ground)
- (4) casing Plastic, 100  
(material) (depth)  
0" if telescope see back.  
(size)
- (5) screen 5' 95'  
(length) (depth to top)  
4", PLASTIC  
(size) (material)
- (6) pump 1 5 GAL.  
(HP) (yield gpm)  
Elect.  
(type power)
- (7) electric log (yes or no) \_\_\_\_\_  
(organization running log) \_\_\_\_\_
- (8) how well bottom plugged Wood plug

DRILLERS REMARKS: B-W

CODED

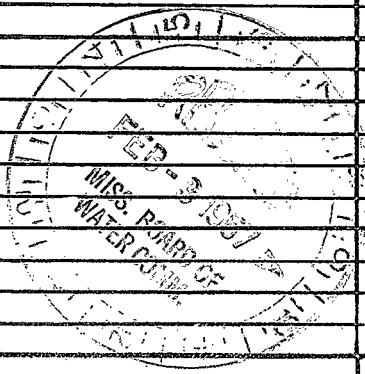

If well telescopes please sketch and show depths.

GROUND LEVEL

X			

SECTION 19

Please indicate well location X.

ADDITIONAL INFORMATION

If more than one screen, show locations of each on sketch.