

Walshall
 E39
 1/68

MISSISSIPPI
 BOARD OF WATER COMMISSIONERS
 416 North State Street
 Jackson, Mississippi 39201

WATER WELL DRILLERS LOG

1-18 1968 Loring or old Waterbury Walshall
 date well completed firm name county well located

LANDOWNER: Doyle Fosterberry
Tyler town MS
 (mailing address)

description of formations encountered	from	to
Topsoil + Clay	0	16
Chalk	16	63
Gravel	65	90
Sand	90	110
Sand + gravel	110	115
Chalk	115	120
Sand	120	145
Coarse Sand	145	160

WELL LOCATION:
 sec 13 T 4 N 10 E
2 miles N of Tyler town
 (distance) (direction) (nearest town)

WELL PURPOSE: home
 (home, irrigation, municipal, industrial)

WELL COMPLETION DATA:

(1) diameter (inches) 4
 (2) total depth (feet) 160
 (3) static water level (feet) 90 below top of ground.
 (4) casing plastic (material) 154 (depth)
4 if telescope see back. (size)
 (5) screen 6' (length) 154 (depth to top)
4 (size) plastic (material)
 (6) pump — (HP) — (yield gpm)
Elec (type power)
 (7) electric log No (yes or no)
Wood peg (organization running log)
 (8) how well bottom plugged


CODED



DRILLERS REMARKS:

If well telescopes please sketch and show depths.

GROUND LEVEL

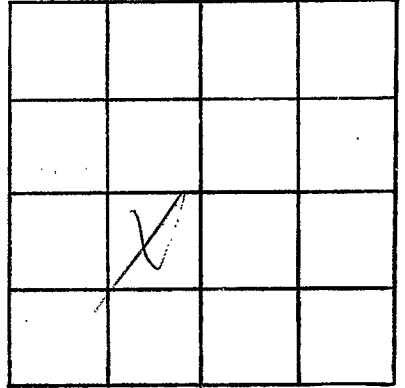

SECTION B2

Please indicate well location X.

ADDITIONAL INFORMATION

If more than one screen, show locations of each on sketch.