

Walthall  
E40  
2-68

CODED

MISSISSIPPI  
BOARD OF WATER COMMISSIONERS  
416 North State Street  
Jackson, Mississippi 39201

WATER WELL DRILLERS LOG

Feb 12 1968 Fitzgerald Well Co Walthall  
date well completed firm name county well located

LANDOWNER: Hazel Johnson  
RR

Tylertown, Miss  
(mailing address)

WELL LOCATION:

sec. 35 T 2 N R 10 E  
2 miles S of Tylertown  
(distance) (direction) (nearest town)

WELL PURPOSE: Domestic  
(home, irrigation, municipal, industrial)

WELL COMPLETION DATA:


- (1) diameter (inches) 4
- (2) total depth (feet) 158
- (3) static water level (feet) 35 below top of ground.
- (4) casing Plaster, 152'  
(material) (depth)  
4 if telescope see back.  
(size)
- (5) screen 6", 152'  
(length) (depth to top)  
4", Plaster  
(size) (material)
- (6) pump ? ?  
(HP) (yield gpm)  
Ch  
(type power)
- (7) electric log no  
(yes or no)  
no  
(organization running log)
- (8) how well bottom plugged Wood plug

description of formations encountered

from to

Red clay	0	5
Red chalk	5	20
Red sand	20	54
White chalk	54	80
Blue chalk	80	100
White chalk	100	120
Fine sand	120	145
Coarse sand	145	150
Coarse sand & gravel	150	158


CODED

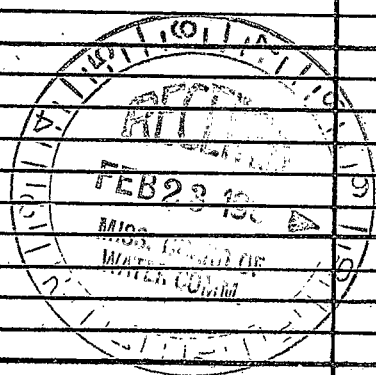

DRILLERS REMARKS:

If well telescopes please sketch and show depths.

GROUND LEVEL

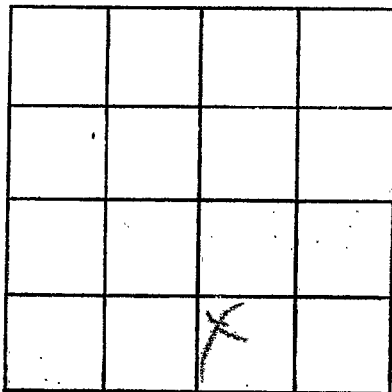

SECTION 35

Please indicate well location X.

ADDITIONAL INFORMATION

If more than one screen,  
show locations of each on sketch.