

**MISSISSIPPI
BOARD OF WATER COMMISSIONERS**
416 North State Street
Jackson, Mississippi 39201

WATER WELL DRILLERS LOG

PIKE
E 41
2-68 CODED

2-19 1968 Eggshead Water Well Service Walthall
date well completed firm name county well located

LANDOWNER: W. J. S. Brumfield
Route Tyler town, MISS
(mailing address)

description of formations encountered	from	to
<u>Topsoil & clay</u>	<u>0</u>	<u>24</u>
<u>Sand</u>	<u>24</u>	<u>62</u>
<u>gravel</u>	<u>62</u>	<u>80</u>
<u>Red Chalk</u>	<u>80</u>	<u>86</u>
<u>gravel</u>	<u>86</u>	<u>108</u>
	<u>108</u>	
		<u>Chalk</u>


WELL LOCATION:
sec. 4 T. 2 N. R. 10 E.
12 miles W of Tyler town
(distance) (direction) (nearest town)

WELL PURPOSE: home
(home, irrigation, municipal, industrial)

- WELL COMPLETION DATA:
- (1) diameter (inches) 4
 - (2) total depth (feet) 104
 - (3) static water level (feet) 95 below above top of ground.
 - (4) casing plastic 101
(material) (depth)
4 if telescope see back.
(size)
 - (5) screen 6' 101
(length) (depth to top)
4 Sch 40
(size) (material)
 - (6) pump 1 —
(HP) (yield gpm)
Elec
(type power)
 - (7) electric log no
(yes or no)

CODED


(organization running log)
(8) how well bottom plugged Wood peg

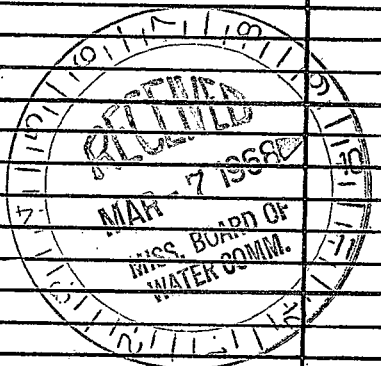

DRILLERS REMARKS:

If well telescopes please sketch and show depths.

GROUND LEVEL

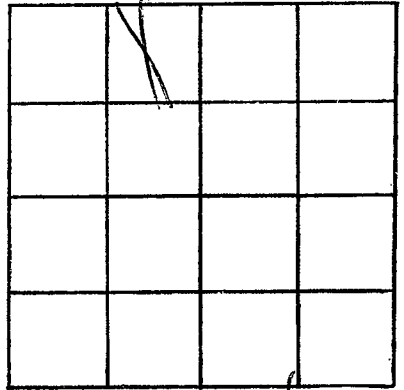

SECTION _____

Please indicate well location X.

ADDITIONAL INFORMATION

If more than one screen, show locations of each on sketch.