

Walthall
E 42
2-68 CODED

MISSISSIPPI
BOARD OF WATER COMMISSIONERS
416 North State Street
Jackson, Mississippi 39201

WATER WELL DRILLERS LOG

Feb 6 1968 Fitzgerald Well Serv Walthall
date well completed firm name county well located

LANDOWNER: Dub Mitchell

description of formations encountered	from	to

PO Box 409

Red clay	0	10
----------	---	----

Feloton, Miss.
(mailing address)

Red sand	10	60
----------	----	----

WELL LOCATION:

Red gravel	60	65
------------	----	----

sec. 23 T. 2 N. R. 10 E.

Red gravel	65	95
------------	----	----

1 miles W of Feloton
(distance) (direction) (nearest town)

Coarse sand & gravel	95	102
----------------------	----	-----

WELL PURPOSE: Home
(home, irrigation, municipal, industrial)

Red sand	102	108
----------	-----	-----

WELL COMPLETION DATA:

Coarse sand & gravel	104	116
----------------------	-----	-----

(1) diameter (inches) 4"

(2) total depth (feet) 121

(3) static water level (feet) 75 below above top of ground.

(4) casing Plastic, 115'
(material) (depth)

4"
(size) If telescope see back.

(5) screen 6', 115'
(length) (depth to top)

4", Plastic
(size) (material)

(6) pump 7 7
(HP) (yield gpm)

Clear
(type power)


(7) electric log no
(yes or no)

(organization running log)

(8) how well bottom plugged Good


DRILLERS REMARKS:

CODED

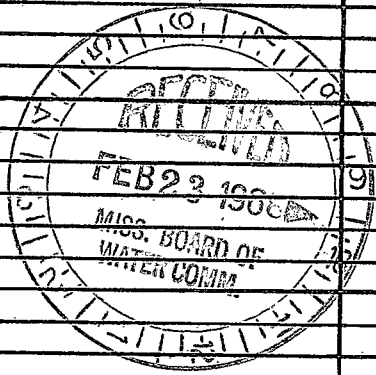

If well telescopes please
sketch and show depths.

GROUND LEVEL

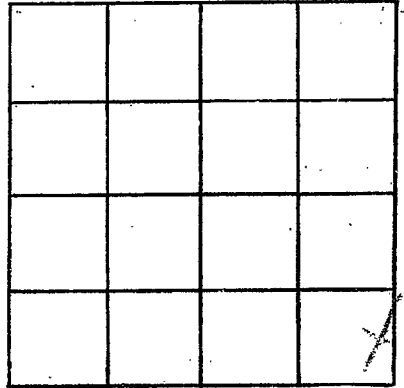

SECTION 23

Please indicate well location X.

ADDITIONAL INFORMATION

If more than one screen,
show locations of each on sketch.