

WALTHALL
E 43
5-14-71

MISSISSIPPI
BOARD OF WATER COMMISSIONERS
416 North State Street
Jackson, Mississippi 39201

CODED

WATER WELL DRILLERS LOG

5-14 1971 F. J. General Well Serv. Walthall
date well completed firm name county well located

LANDOWNER:

Bill Johnson

R.R. Glastonbury Drive
(mailing address)

description of formations
encountered

from

to

Red Clay 6 22
Red Sandstone 22 115
Coarse sand & gravel 115 140

WELL LOCATION:

sec. 9 T 2 S R 1 E
3 miles West of Glastonbury
(distance) (direction) (nearest town)

WELL PURPOSE:

(home, irrigation, municipal, industrial)

WELL COMPLETION DATA:

(1) diameter (inches) 4
(2) total depth (feet) 140
(3) static water level (feet) 100 below
top of ground.

(4) casing plastic 132
(material) (depth)

4
(size) If telescope see back.

(5) screen 8 132
(length) (depth to top)

4 plastic
(size) (material)

(6) pump 3/4 12
(HP) (yield gpm)

electric
(type power)

(7) electric log yes
(yes or no)

(organization running log)

(8) how well bottom plugged completely

CODED


JUN 14 1971

DRILLERS REMARKS:

MISS. BD. OF
WATER COMM.

If well telescopes please
sketch and show depths.

GROUND LEVEL

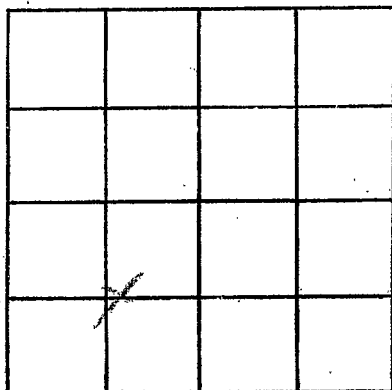

SECTION 9

Please indicate well location X.

ADDITIONAL INFORMATION

If more than one screen,
show locations of each on sketch.