

WALTHALL  
E 46  
2-68  
CODED

MISSISSIPPI  
BOARD OF WATER COMMISSIONERS  
416 North State Street  
Jackson, Mississippi 39201

WATER WELL DRILLERS LOG

3-4 1968 *Walthall Water Well* *Walthall*  
date well completed firm name county well located


LANDOWNER: *Walthall*  
*Red Lupton - Mo*  
(mailing address)

description of formations encountered	from	to
<i>top soil &amp; clay</i>	<i>0</i>	<i>28</i>
<i>Red sand</i>	<i>28</i>	<i>104</i>
<i>gravel &amp; sand</i>	<i>104</i>	<i>120</i>

WELL LOCATION:  
sec *22* T *2* N R *10* E  
S  
*4* miles *W* *Lupton*  
(distance) (direction) (nearest town)

WELL PURPOSE: *home*  
(home, irrigation, municipal, industrial)

- WELL COMPLETION DATA:
- (1) diameter (inches) *4*
  - (2) total depth (feet) *120*
  - (3) static water level (feet) *85* below above top of ground.
  - (4) casing *plastic 1 1/4*  
(material) (depth)  
*4* if telescope see back  
(size)
  - (5) screen *6'* *1 1/4*  
(length) (depth to top)  
*4* *sch 40*  
(size) (material)
  - (6) pump *slu* *120*  
(HP) (yield gpm)  
(type power)
  - (7) electric log *no*  
(yes or no)  
(organization running log)
  - (8) how well bottom plugged *Wood peg*

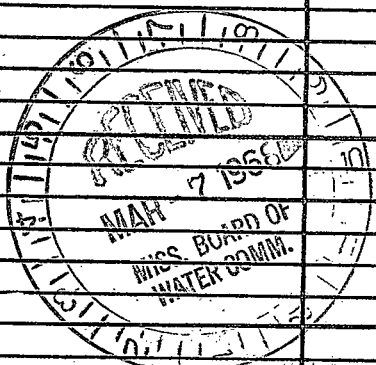

DRILLERS REMARKS:

