

**MISSISSIPPI  
BOARD OF WATER COMMISSIONERS**  
416 North State Street  
Jackson, Mississippi 39201

**WATER WELL DRILLERS LOG**

Walthall  
EA 7  
8-68 **CODED**

8-6 date well completed      1968 *Fitzgerald Water Well* firm name      Walthall county well located

LANDOWNER: *Spring Hill Church*  
*Tyler town Miss*  
(mailing address)

description of formations encountered	from	to
<i>Chalk</i>	<i>0</i>	<i>10</i>
<i>Sand</i>	<i>10</i>	<i>58</i>
<i>Sand &amp; gravel</i>	<i>58</i>	<i>52</i>


WELL LOCATION:  
sec. *1* T. *2* N. R. *10* E.  
S. W.  
*3* miles N of *Tyler town*  
(distance) (direction) (nearest town)

WELL PURPOSE: *Church*  
(home, irrigation, municipal, industrial)

**WELL COMPLETION DATA:**

- (1) diameter (inches) *4*
- (2) total depth (feet) *56*
- (3) static water level (feet) *5'* below top of ground.
- (4) casing *plastic 50*  
(material) (depth)  
*4* if telescope see back.  
(size)
- (5) screen *6'* *58*  
(length) (depth to top)  
*1/2* Sch. *40*  
(size) (material)
- (6) pump \_\_\_\_\_  
(HP) (yield gpm)  
  
(type power)
- (7) electric log *no*  
(yes or no)  
  
(organization running log)
- (8) how well bottom plugged *wood peg*


**CODED**

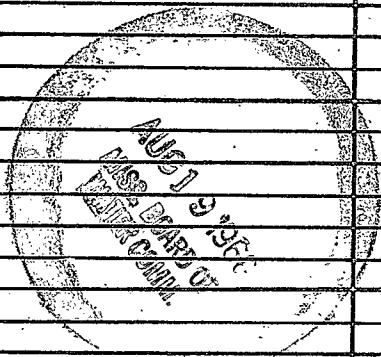

DRILLERS REMARKS:

If well telescopes please sketch and show depths.

GROUND LEVEL

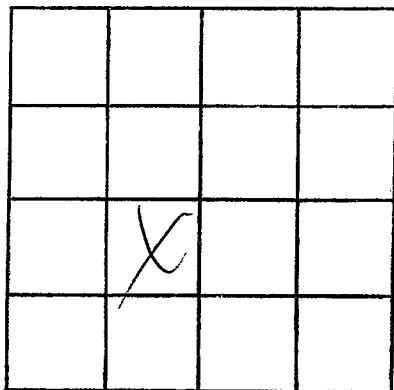

SECTION   /  

Please indicate well location X.

ADDITIONAL INFORMATION

If more than one screen, show locations of each on sketch.