

WALTHALL  
E 48  
6-68  
CODED

MISSISSIPPI  
BOARD OF WATER COMMISSIONERS  
416 North State Street  
Jackson, Mississippi 39201

WATER WELL DRILLERS LOG

June 27 1968 J. T. Courapton Walthall  
date well completed firm name county well located

LANDOWNER: Tony Roberts

description of formations encountered	from	to
clay	0	40
rocks & sand	40	60
sand & rocks	60	126

Ty Leaton, Miss  
(mailing address)


WELL LOCATION:  
sec. 36 T 2 N R 9 E  
NW SW NE W  
1.4 miles East of N/E Comb  
(distance) (direction) (nearest town)

WELL PURPOSE: Home  
(home, irrigation, municipal, industrial)

WELL COMPLETION DATA:

- (1) diameter (inches) 4"
- (2) total depth (feet) 126'
- (3) static water level (feet) 90' below top of ground.
- (4) casing Plastic, 120'  
(material) (depth)  
4" (size) if telescope see back.
- (5) screen 6' 126"  
(length) (depth to top)  
4" Plastic  
(size) (material)
- (6) pump 1/2 8  
(HP) (yield gpm)  
D.C.  
(type power)
- (7) electric log \_\_\_\_\_  
(yes or no)  
(organization running log)
- (8) how well bottom plugged wood


CODED

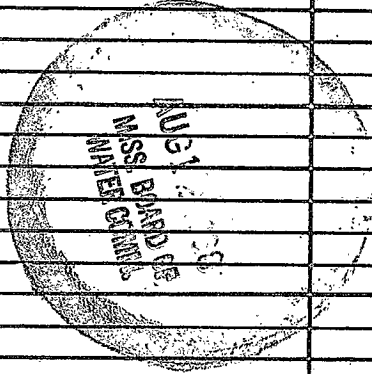

DRILLERS REMARKS:

If well telescopes please sketch and show depths.

GROUND LEVEL

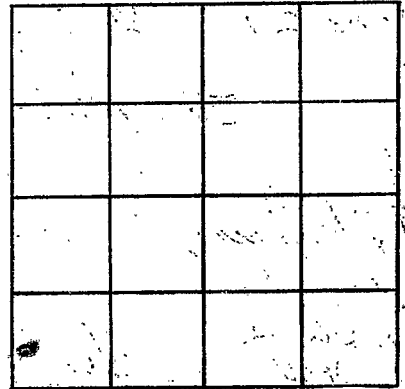

SECTION 36

Please indicate well location X.

ADDITIONAL INFORMATION

If more than one screen, show locations of each on sketch.