

Walthall
E 49
5-17-67

MISSISSIPPI
 BOARD OF WATER COMMISSIONERS
 416 North State Street
 Jackson, Mississippi 39201

WATER WELL DRILLERS LOG

5-17 date well completed 1967 Framwell & Huff Brown firm name Walthall county well located

LANDOWNER:
Walter Morris
Zylertown, Miss
 (mailing address)

description of formations encountered

	from	to
<u>Red clay</u>	<u>0</u>	<u>20</u>
<u>Sand & gravel</u>	<u>20</u>	<u>98</u>


WELL LOCATION:
 sec. 20 T. 2 N. R. 10 E. S. 5 W.
6 miles W of Zylertown
 (distance) (direction) (nearest town)

WELL PURPOSE: Home
 (home, irrigation, municipal, industrial)

WELL COMPLETION DATA:

- (1) diameter (inches) 4
- (2) total depth (feet) 98
- (3) static water level (feet) 70 below above top of ground.
- (4) casing 4 (material), 93 (depth),
 (size) If telescope see back.
- (5) screen 5 (length), (depth to top)
 (size), (material)
- (6) pump 3/4 (HP), 5 (yield gpm)
elec (type power)
- (7) electric log no (yes or no)
 (organization running log)
- (8) how well bottom plugged W/B


CODED

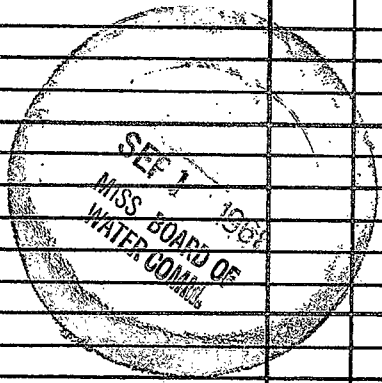

DRILLERS REMARKS:

If well telescopes please sketch and show depths.

GROUND LEVEL

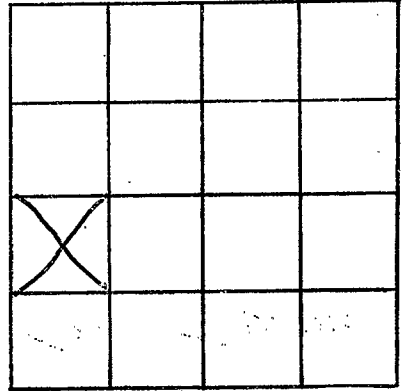

SECTION 20

Please indicate well location X.

ADDITIONAL INFORMATION

If more than one screen,
show locations of each on sketch.