

**MISSISSIPPI
BOARD OF WATER COMMISSIONERS**
416 North State Street
Jackson, Mississippi 39201


WATER WELL DRILLERS LOG

Walthall
E 500
8-1-67 **CODED**

Aug 1 1967 Fernie & Elbert Brown Walthall
date well completed firm name county well located


LANDOWNER:	description of formations encountered	from	to
<u>RT 3</u> <u>Austing McKenzie</u> <u>Tylertown Miss</u> (mailing address)	<u>Clay sand</u> <u>sand + gravel</u>	<u>10</u> <u>40</u> <u>65</u>	<u>40</u> <u>65</u> <u>110</u>
WELL LOCATION: sec. <u>13</u> T. <u>2</u> N. R. <u>100</u> E. <u>2</u> miles <u>N</u> of <u>Tylertown</u> (distance) (direction) (nearest town)			
WELL PURPOSE: <u>Home</u> (home, irrigation, municipal, industrial)			
WELL COMPLETION DATA:			
(1) diameter (inches) <u>4"</u>			
(2) total depth (feet) <u>110'</u>			
(3) static water level (feet) <u>70'</u> <u>below</u> top of ground.			
(4) casing <u>plastic</u> , <u>110'</u> (material) (depth)			
_____ if telescope see back. (size)			
(5) screen <u>5'</u> , <u>105'</u> (length) (depth to top)			
<u>4"</u> , <u>plastic</u> (size) (material)			
(6) pump <u>1</u> <u>6</u> (HP) (yield gpm)			
<u>Elect</u> (type power)			
(7) electric log _____ (yes or no)			
_____ (organization running log)			
(8) how well bottom plugged <u>W U</u>			
REMARKS: <u>Set Pump</u>			

CODED

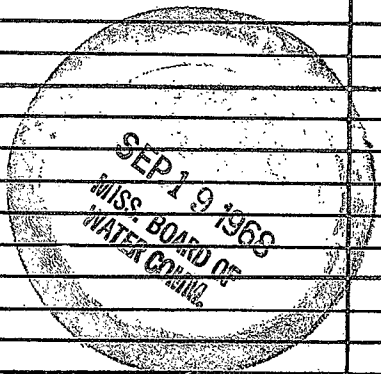

If well telescopes please sketch and show depths.

GROUND LEVEL

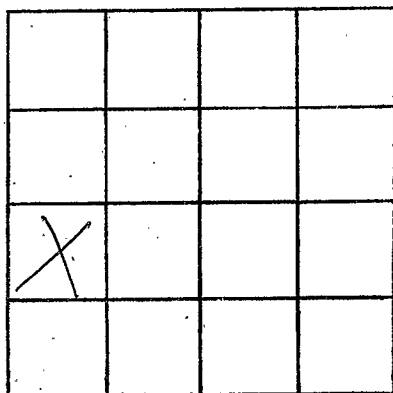

SECTION 13

Please indicate well location X.

ADDITIONAL INFORMATION

If more than one screen,
show locations of each on sketch.