

Walthall
 ESI
 10-21-67

MISSISSIPPI
 BOARD OF WATER COMMISSIONERS
 416 North State Street
 Jackson, Mississippi 39201

WATER WELL DRILLERS LOG

10-21-67 date well completed
 67 Fernis Elbert Brown firm name
 Walthall county well located

LANDOWNER:
 Purdee, Martin
 Tylertown
 (mailing address)


description of formations encountered	from	to
RED SAND & GRAVEL	0	80
GRAVEL	80	91

WELL LOCATION:
 sec 26 T 20 R 10E
 S
 1 miles W of Tylertown
 (distance) (direction) (nearest town)

WELL PURPOSE: Home
 (home, irrigation, municipal, industrial)

- WELL COMPLETION DATA:
- (1) diameter (inches) 2"
 - (2) total depth (feet) 91'
 - (3) static water level (feet) 60' below top of ground.
 - (4) casing GALV 91' (material), (depth), 2" (size) if telescope see back.
 - (5) screen 5' 86' (length), (depth to top), 2" BRASS (size), (material)
 - (6) pump (HP) (yield gpm) (type power)
 - (7) electric log (yes or no) (organization running log)
 - (8) how well bottom plugged WU


CODED

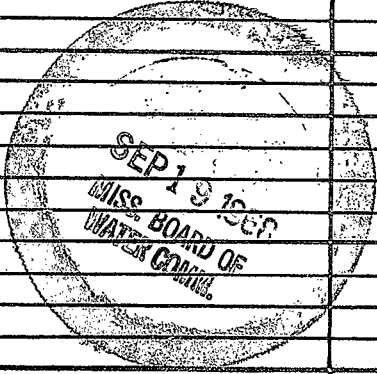

REMARKS: NO
 mp available
 time

If well telescopes please sketch and show depths.

GROUND LEVEL

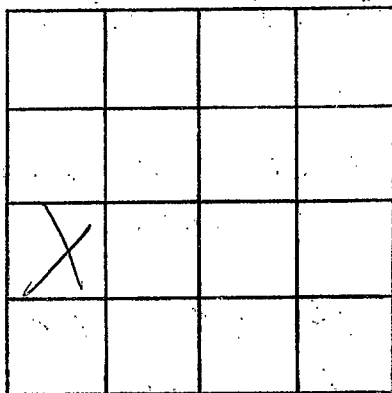

SECTION 26

Please indicate well location X.

ADDITIONAL INFORMATION

If more than one screen, show locations of each on sketch.