

WALTHALL
E 52 CODED
1-15-61

WATER WELL DRILLERS LOG

E-300

Date: 1-15, 1961, Driller: W. J. Rhyger & Co County Walthall
(Name)

(1) Owner of Land: AB Pontwell
(Name)
Next on R2 -
Swan
(Address)
(2) Location: S 1/4, SE 1/4, Sec. 25 T2R10
1 miles S of Harmon
(distance) (direction) (Nearest Town)
(3) Topography: Hilly
(Hilly) (Flat) (Level)
(4) Purpose of Well: House Use
(Domestic Irrigation
Municipal, Industrial, Other)

| Description & Color of Materials Sand, Clay, Red Clay, Shell, etc. | Thick- ness Feet | Depth Feet |
|---|------------------------|---------------|
| <u>Dark soil & clay</u> | <u>0</u> | <u>20</u> |
| <u>Red Sand</u> | <u>20</u> | <u>50</u> |
| <u>White chalk</u> | <u>50</u> | <u>65</u> |
| <u>Thick soap</u> | <u>65</u> | <u>80</u> |
| <u>White chalk</u> | <u>80</u> | <u>92</u> |
| <u>White chalk</u> | <u>92</u> | <u>145</u> |
| <u>Sand</u> | <u>145</u> | <u>150</u> |
| <u>Blue Chalk</u> | <u>150</u> | <u>255</u> |
| <u>Fine Sand Blue</u> | <u>255</u> | <u>285</u> |
| <u>Coarse Sand</u> | <u>280</u> | <u>300</u> |


Information upon completion of well:

(1) Diameter 2 1/4 inches.
(2) Total Depth 299 feet.
(3) Water Level 65 feet below top of ground.
(4) Cased to 294, Size 2 1/2 x 2
(5) Screen: Size 2", Length 5'
(6) Were any formations sealed against pollution?
_____ yes, no.

If YES depth of formation _____
Why _____

Drillers Remarks: _____

CODED

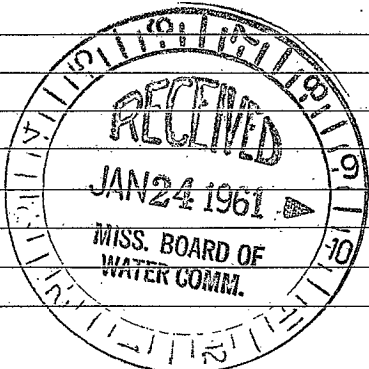

(Use Back Side)

Well No.

