

Walthall
E 54
1-7-69

MISSISSIPPI
BOARD OF WATER COMMISSIONERS
416 North State Street
Jackson, Mississippi 39201

CODED CODED

WATER WELL DRILLERS LOG

Jan 7 1969 Fitzgerald well Walthall
date well completed firm name county well located

LANDOWNER:
Clifton Boughton
R.R. Tylbert (mailing address)

description of formations encountered	from	to
<u>Red clay</u>	<u>0</u>	<u>15</u>
<u>Red sand & gravel</u>	<u>15</u>	<u>60</u>
<u>Red gravel</u>	<u>60</u>	<u>90</u>
<u>Red clay</u>	<u>90</u>	<u>110</u>
<u>Coarse sand & gravel</u>	<u>110</u>	<u>120</u>

WELL LOCATION:
sec. 15 T 2 N R. 10 E
S W
3 miles W of Tylbert
(distance) (direction) (nearest town)

WELL PURPOSE: Home
(home, irrigation, municipal, industrial)

WELL COMPLETION DATA:

(1) diameter (inches) 4

(2) total depth (feet) 120

(3) static water level (feet) 80 below above top of ground.

(4) casing Plastic, 114' (material) (depth)
4" if telescope see back. (size)

(5) screen 6', 114' (length) (depth to top)
4", Plastic (size) (material)

(6) pump ?, ? (HP) (yield gpm)
Flow (type power)

(7) electric log no (yes or no)
(organization running log)

(8) how well bottom plugged completely

DRILLERS REMARKS:


CODED

MISS. DEPT. OF WATER CONTROL

FEB 13 1969

If well telescopes please sketch and show depths.

GROUND LEVEL

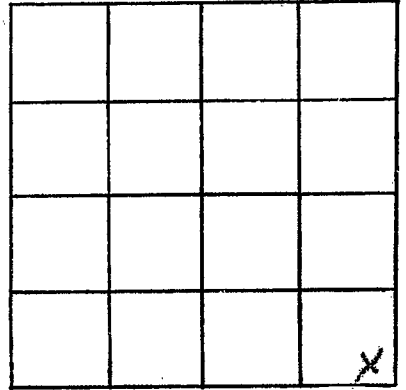

SECTION 15

Please indicate well location X.

ADDITIONAL INFORMATION

If more than one screen,
show locations of each on sketch.