

WALTHALL

E 55

2-15-69

MISSISSIPPI
 BOARD OF WATER COMMISSIONERS
 416 North State Street
 Jackson, Mississippi 39201

WATER WELL DRILLERS LOG

Feb 15 1969
date well completed

Fitzgerald Well Drilling
firm name

Walthall
county well located

LANDOWNER: Roy Laster

description of formations encountered

from to

RT 5, Tylertown, Miss

(mailing address)

Red Clay	0	20
Red Sand	20	80
Red gravel	80	95
Red Sand	95	125
Coarse sand & gravel	125	131

WELL LOCATION:

sec 33 T 2 N R 10 E
 5 miles SW of Tylertown
 (distance) (direction) (nearest town)

WELL PURPOSE: Home
(home, irrigation, municipal, industrial)

WELL COMPLETION DATA:

- (1) diameter (inches) 4"
- (2) total depth (feet) 131'
- (3) static water level (feet) 100 below top of ground.
- (4) casing Plastic 125'
(material) (depth)
4" if telescope see back.
(size)
- (5) screen 6" 125'
(length) (depth to top)
4" Plastic
(size) (material)
- (6) pump 1 8
(HP) (yield gpm)
Electric
(type power)
- (7) electric log No
(yes or no)
Woodpeck
(organization running log)
- (8) how well bottom plugged woodpeck


DRILLERS REMARKS:

LEADER

MISSISSIPPI
 BOARD OF WATER COMMISSIONERS
 JACKSON, MISSISSIPPI

If well telescopes please sketch and show depths.

GROUND LEVEL

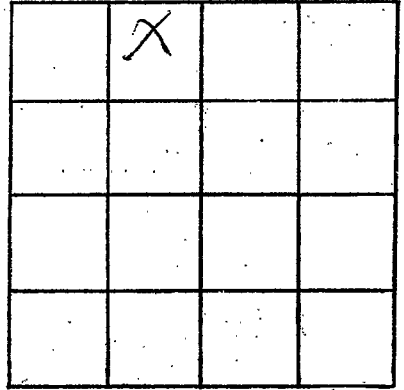

SECTION EE

Please indicate well location X.

ADDITIONAL INFORMATION

If more than one screen, show locations of each on sketch.