

Walthall  
E 57  
6-69

MISSISSIPPI  
BOARD OF WATER COMMISSIONERS  
416 North State Street  
Jackson, Mississippi 39201

CODED

WATER WELL DRILLERS LOG

6-6 1969 *Fitzgerald* Walthall  
date well completed firm name county well located

LANDOWNER:  
*Chris Honea*  
*Tylertown, Miss.*  
(mailing address)

description of formations encountered	from	to
	<i>Red clay</i>	<i>0</i>
<i>Red sand</i>	<i>20</i>	<i>70</i>
<i>Coarse sand &amp; gravel</i>	<i>70</i>	<i>103</i>

WELL LOCATION:  
sec. *35* T. *3* N. R. *10* E.  
*1* N miles *Tylertown*  
(distance) (direction) (nearest town)

WELL PURPOSE: *Home*  
(home, irrigation, municipal, industrial)

WELL COMPLETION DATA:

(1) diameter (inches) *4*

(2) total depth (feet) *103*

(3) static water level (feet) *70* below above top of ground.

(4) casing *Plastic 97*  
(material) (depth)  
*4* if telescope see back.  
(size)

(5) screen *6 97*  
(length) (depth to top)  
*4* *plastic*  
(size) (material)

(6) pump *?* *?*  
(HP) (yield gpm)  
*Elm*  
(type power)

(7) electric log *no*  
(yes or no)  
(organization running log)


(8) how well bottom plugged *used py*

DRILLERS REMARKS:

1969  
MISS. Bd. OF WATER COMM.

If well telescopes please  
sketch and show depths.

SECTION 25

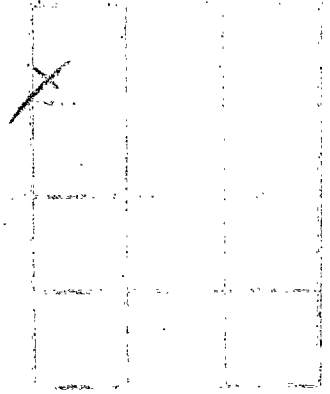

SECTION 25

If well telescopes well location is

ADDITIONAL INFORMATION

If more than one screen,  
show locations of each on sketch.