

Walthall
E 58
7-69

MISSISSIPPI
BOARD OF WATER COMMISSIONERS
416 North State Street
Jackson, Mississippi 39201

CODED

WATER WELL DRILLERS LOG

7-18 1969 Fitzgerald Walthall
date well completed firm name county well located


LANDOWNER:	description of formations encountered	from	to
<u>Julius Becko</u> <u>R.R. Tylertown, Miss</u> (mailing address)	<u>Red Clay</u>	0	20
	<u>Red Sand</u>	20	70
	<u>Red gravel</u>	70	90
	<u>Fine Sand</u>	90	120
	<u>Coarse sand & gravel</u>	120	135
WELL LOCATION: sec. <u>20</u> T. <u>2</u> N. R. <u>10</u> E. <u>3</u> miles <u>W</u> of <u>Tylertown</u> (distance) (direction) (nearest town)			
WELL PURPOSE: <u>Home</u> (home, irrigation, municipal, industrial)			
WELL COMPLETION DATA: (1) diameter (inches) <u>4</u> (2) total depth (feet) <u>135</u> (3) static water level (feet) <u>95</u> below above top of ground. (4) casing <u>Plastic</u> , <u>129</u> , (material) (depth) <u>4</u> if telescope see back. (size) (5) screen <u>6</u> , <u>129</u> (length) (depth to top) <u>4</u> , <u>plastic</u> (size) (material) (6) pump <u>1/2</u> , <u>10</u> (HP) (yield gpm) <u>Electric</u> (type power) (7) electric log <u>Yes</u> (yes or no) (organization running log) (8) how well bottom plugged <u>is red py</u>			
DRILLERS REMARKS:			

AUG 4 1969

MISS. DEPT. OF
WATER CONTROL

If well telescopes please
sketch and show depths.

GROUND LEVEL

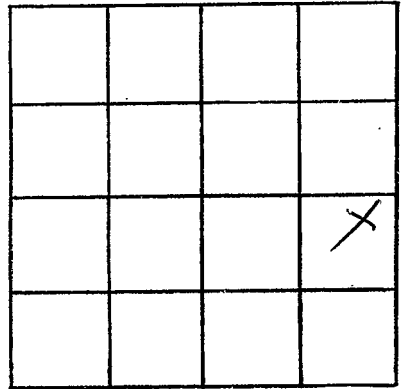

SECTION 20

Please indicate well location X.

ADDITIONAL INFORMATION

If more than one screen,
show locations of each on sketch.